T. 39 S., R. 5 W., W. M.

RESERVOIRS LOCATED: #1 - 570'S. & 240'E.,
#2 - 2000'S. & 830'E., BOTH
FROM NE COR., NW 1/4 NE 1/4, SEC. 10.

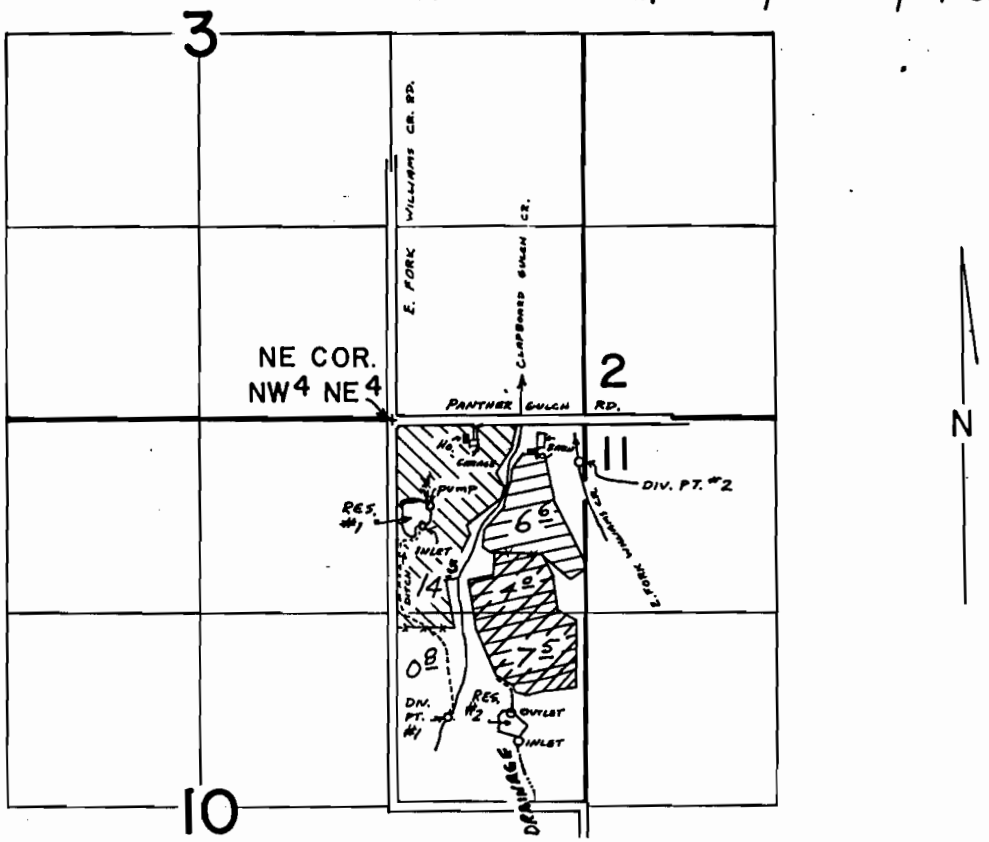

DIV. PTS. LOCATED: #1 - 2030'S. & 350'E.
#2 - 290'S & 1290'E., BOTH
FROM NE COR., NW 1/4 NE 1/4, SEC. 10.

Res #1 Permit 39935

Res #2 " "

Permit 40135

FINAL PROOF SURVEY

UNDER

PRIMARY	R-51671 51672	R-6392 39935
SUPPLEMENTAL		

Application No. 53677 Permit No. 41035

IN NAME OF

GEORGE BRETZ

Surveyed Oct. 3, 1980, by BRUCE R. SUND

Scale: 4" = 1 mile

PTS-1980-14B
PTS-1979-14A

BSJ