


T. 37 S., R. 5 W., W.M.

Sec. 19

NW 1/4 NE 1/4

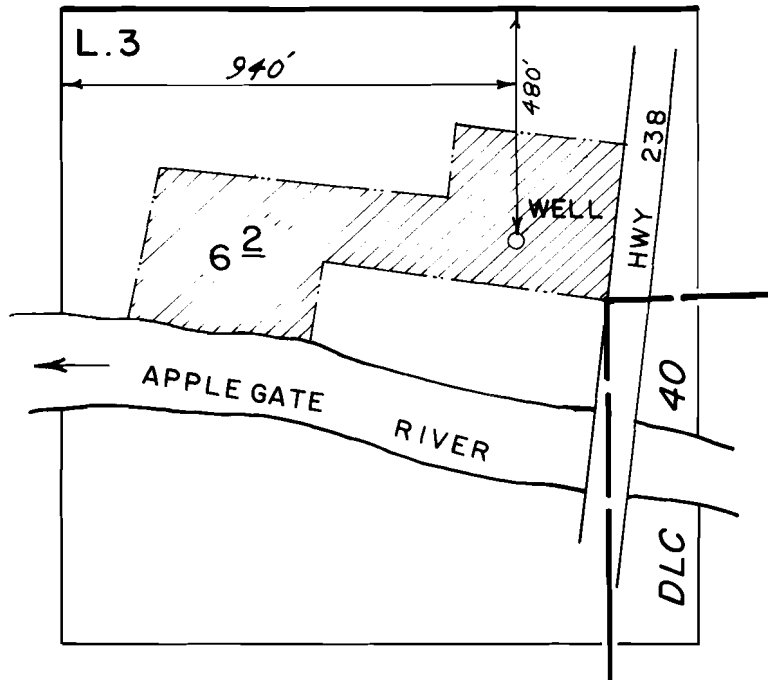

Scale 1" = 1320'

FINAL PROOF SURVEY

UNDER

Application No. G-5321 Permit No. G-5228
IN NAME OF

GEORGE E. BRETZ

Surveyed Oct. 3, 1980, by B. R. SUND