T. 37 S., R. 6 W., W.M.

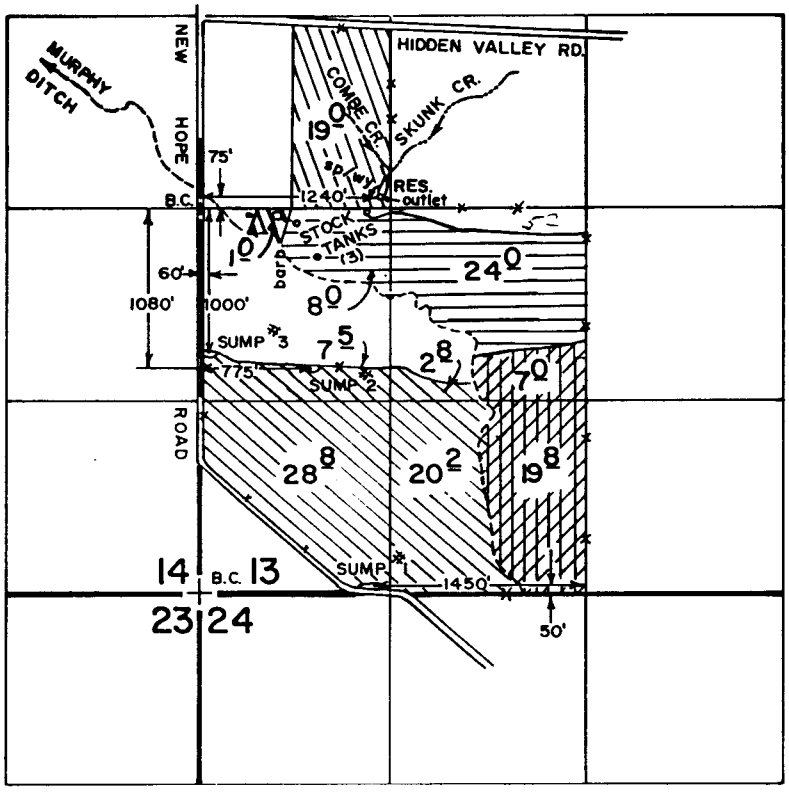

RECEIVED
AUG 3 1987
WR. DIST. 14
GRANTS PASS, ORE.

FINAL PROOF SURVEY

UNDER

67523	48255
R-56577	R-7348
56578	43108

Application No. G-8936 Permit No. G-8334

IN NAME OF

CLYDE C. & D. BUD COMBE

Surveyed OCT. 4 1983, by B. S. JAMES

SCALE: 4" = 1 MILE

- SUP. from SUMP #1
- SUP. from SUMPS #2 & #3
- SUP. from RES.
- PRIM. from SUMP #1
- PRIM. from RES.

B50-2-4 TWB