


T. 34 S., R. 5 W., W. M.

Sec. 17

SE 1/4 NE 1/4

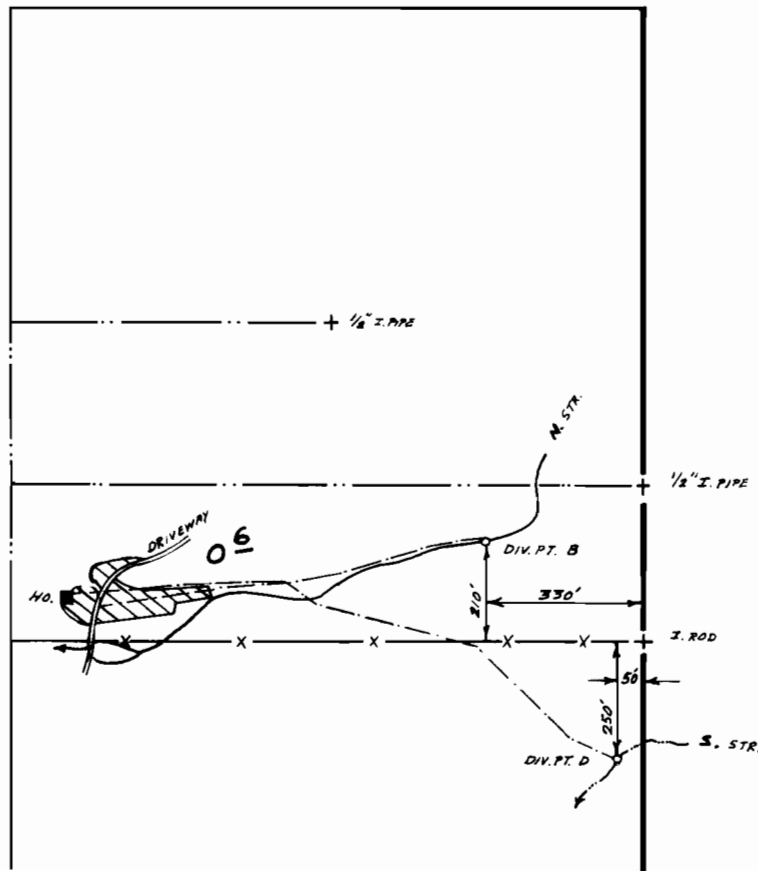

Scale 1" = 400'

FINAL PROOF SURVEY
UNDER

Application No. **51564**..... Permit No. **37394**.....
IN NAME OF

...**BERT A. & DONNA J. ISLEY**.....

Surveyed **Aug. 26, 1986**., by **B.S. JAMES**.....