


T. 33 S., R. 6 W., W.M.

Sec. 31

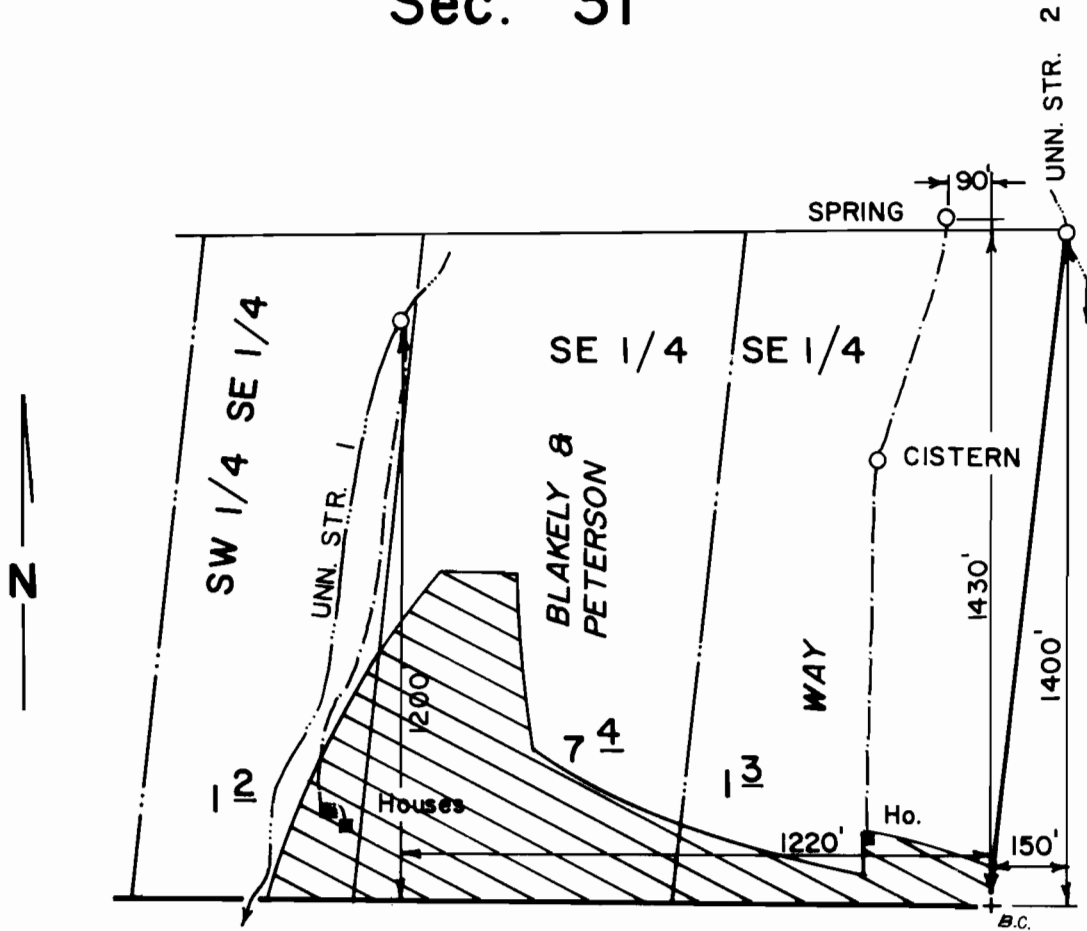

Scale 1" = 400'

FINAL PROOF SURVEY
UNDER

Application No. 53743 Permit No. 40360

IN NAME OF
WILLIAM D. & H. JOAN PETERSON
FREDERICK T. & VIRGINIA L. BLAKELY
JOYCE WAY

Surveyed Aug. 23, 1984, by J.R. WOODROOF
April 30, 1986, B.S. JAMES