


T.35S.,R.7W.,W.M.

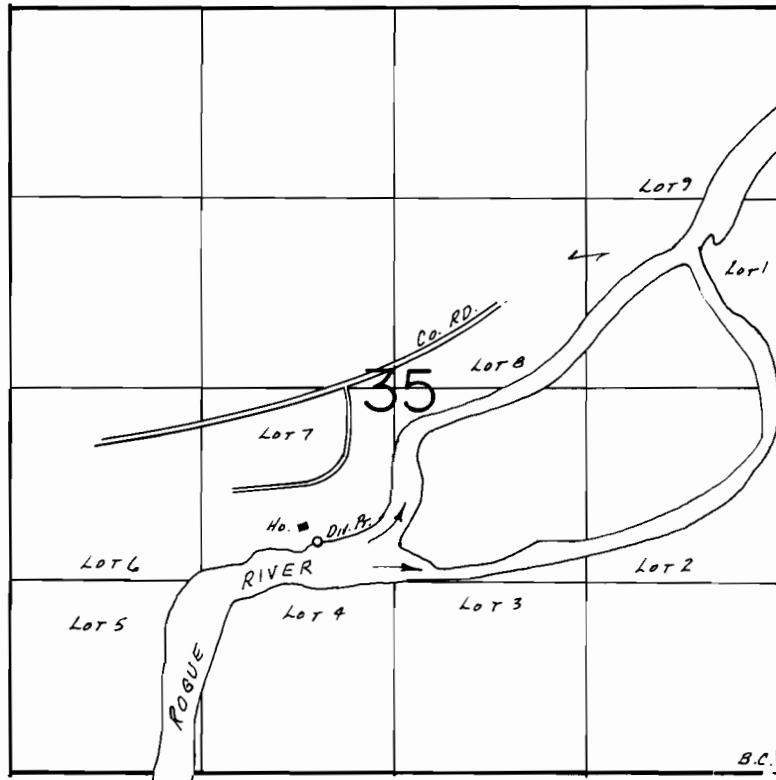

Div. Pt. Loc.: 1050'S. & 510'W. FROM CENTER SECTION 35.

SCALE: 1"=1320'

FINAL PROOF SURVEY
UNDER

Application No. 60338.. Permit No. 45306.....
IN NAME OF

KARL M. & BEATRICE J. BENNETT

Surveyed Oct. 23... 19.85, by B.S.JAMES.....