


T. 37 S., R. 6 W., W.M.

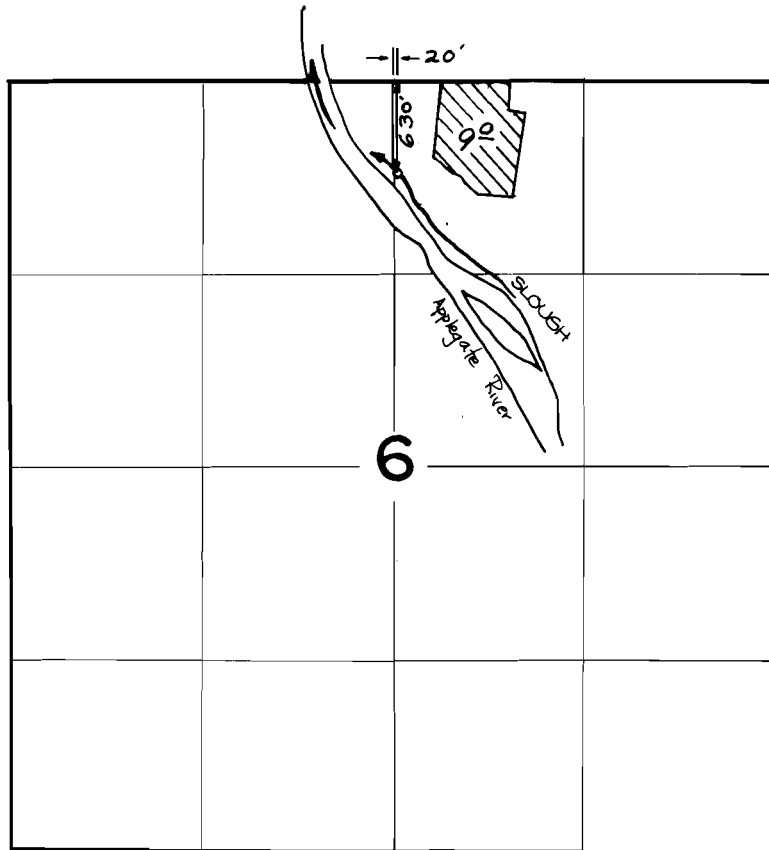

**FINAL PROOF SURVEY**  
UNDER

TRANSFER NO. 3928

Application No. ~~61840~~ Permit No. ~~45934~~.....

IN NAME OF

**JEAN MOUNT & T. NIK TAYLOR**

Surveyed AUG. 11, 1982, by B. S. JAMES.....