


T.37S.,R.6W., W.M.

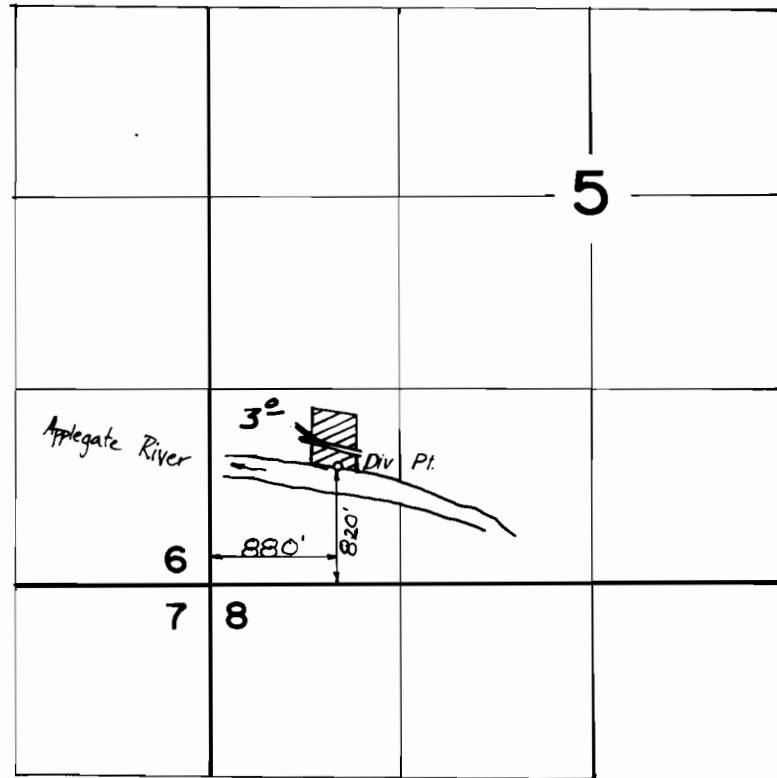

FINAL PROOF SURVEY UNDER

Application No. 61252.. Permit No. 46474....
IN NAME OF

.....**SPEEDY & EDDIE NUTZ**.....

Surveyed AUG 10, 1982, by B. S. JAMES.....