


T. 37 S., R. 6 W., W.M.

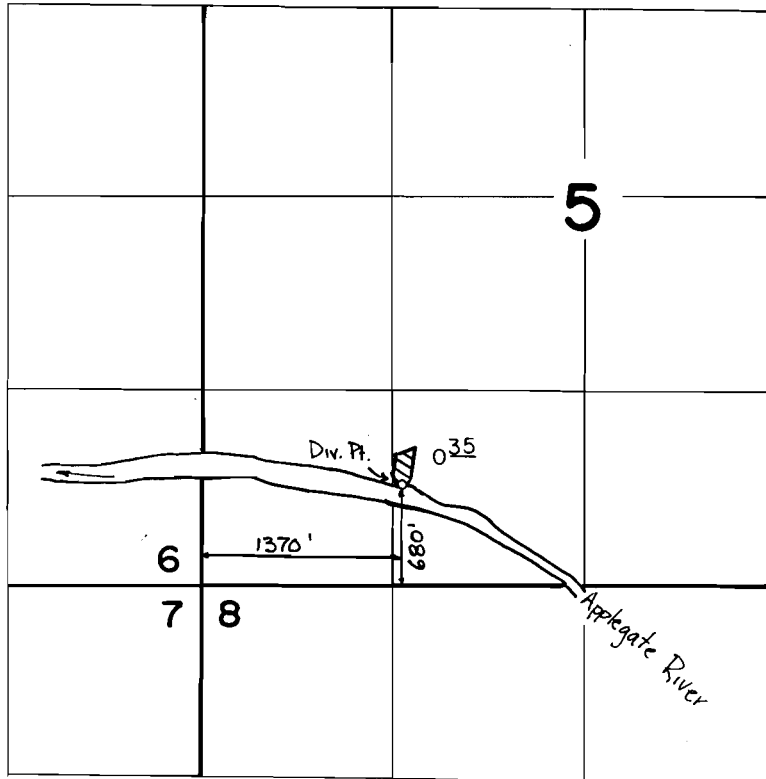

FINAL PROOF SURVEY UNDER

Application No. 62192 Permit No. 46485

IN NAME OF

LEWIS TAGLIERE

Surveyed AUG. 10., 1982., by B. S. JAMES