

722847
25395
BOYLSTON, K6, BSL0W SEC15


Sec. 10

Sec. 11

Sec. 2


LEPLEGATE
AMP FIRE GIRLS
AMERICA

12621

8021


LAKE OF THE WOODS

Application No. 58606
Permit No. 44227

POINT OF DIVERSON, 802' S X 1262' E of
THE NW CORNER OF SEC10, T37S, R5E.
POINT OF USE. LOT 6, BK K 5, LAKE OF THE
WOODS SUMMER HOMES SURVEY

RECEIVED

MAY 02 1979
WATER RESOURCES DEPT.
SALEM, OREGON

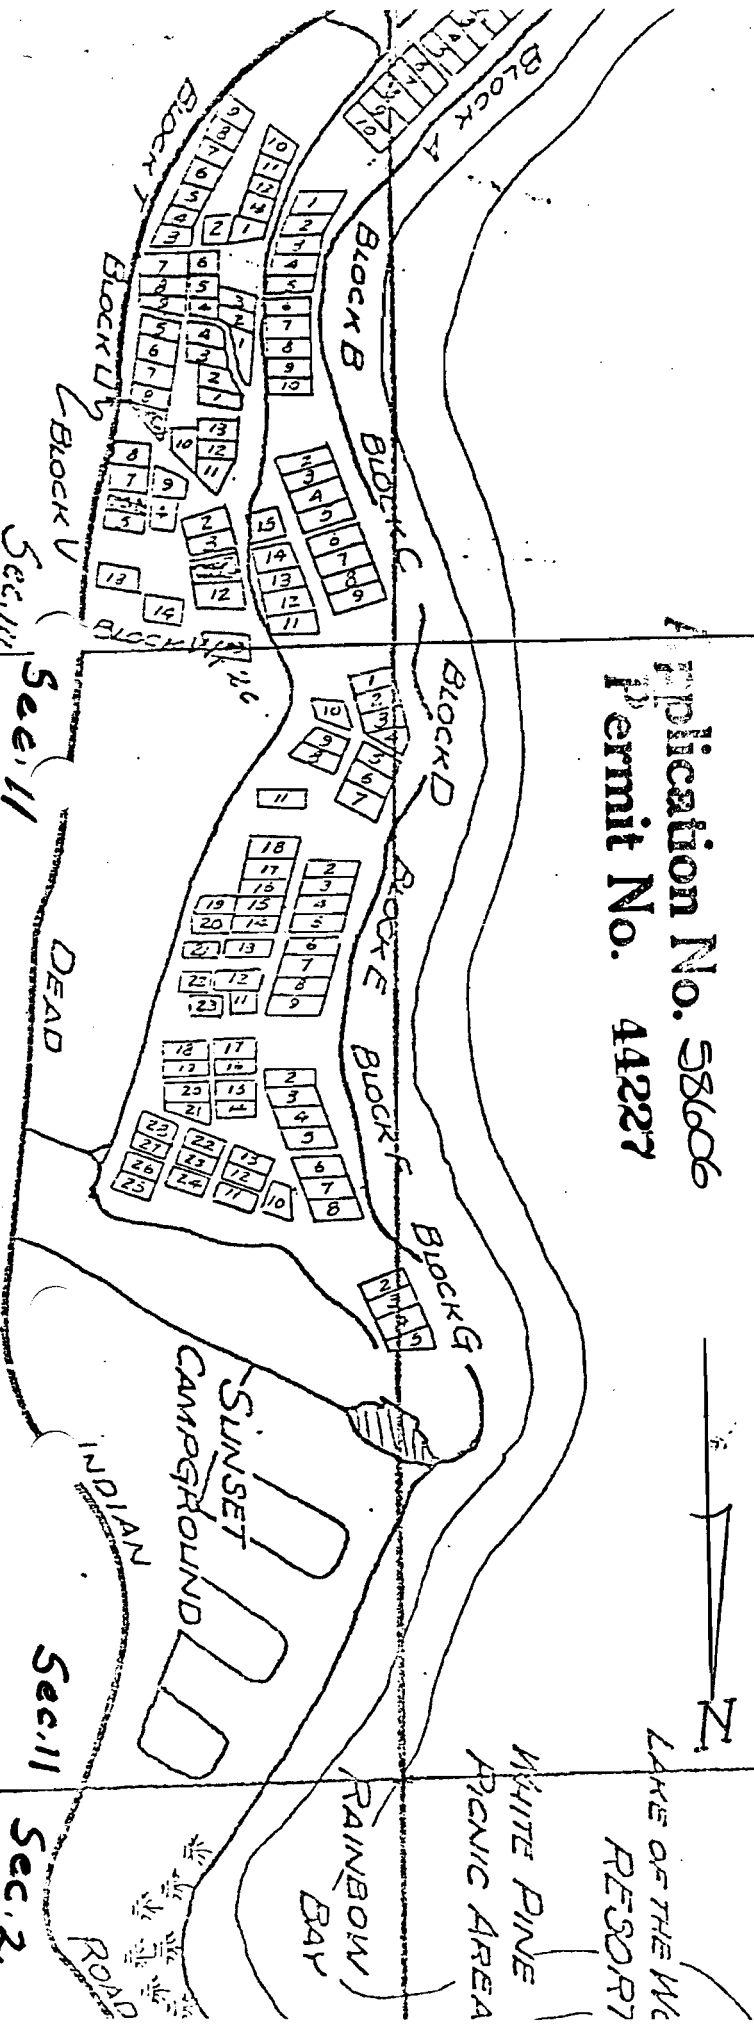

Sec. 10

DEAD

SUNSET CAMPGROUND

INDIAN PICNIC AREA

Sec. 11

Sec. 2

N

LAKE OF THE WOODS RESORT

WHITE PINE PICNIC AREA

RAINBOW BAY

ROAD