


46966  
56351

C.M. McGinty  
204 Medford Heights  
Medford, Oregon

T 37S R 5 E  
NW NW Sec 14

Scale 1" = 60'

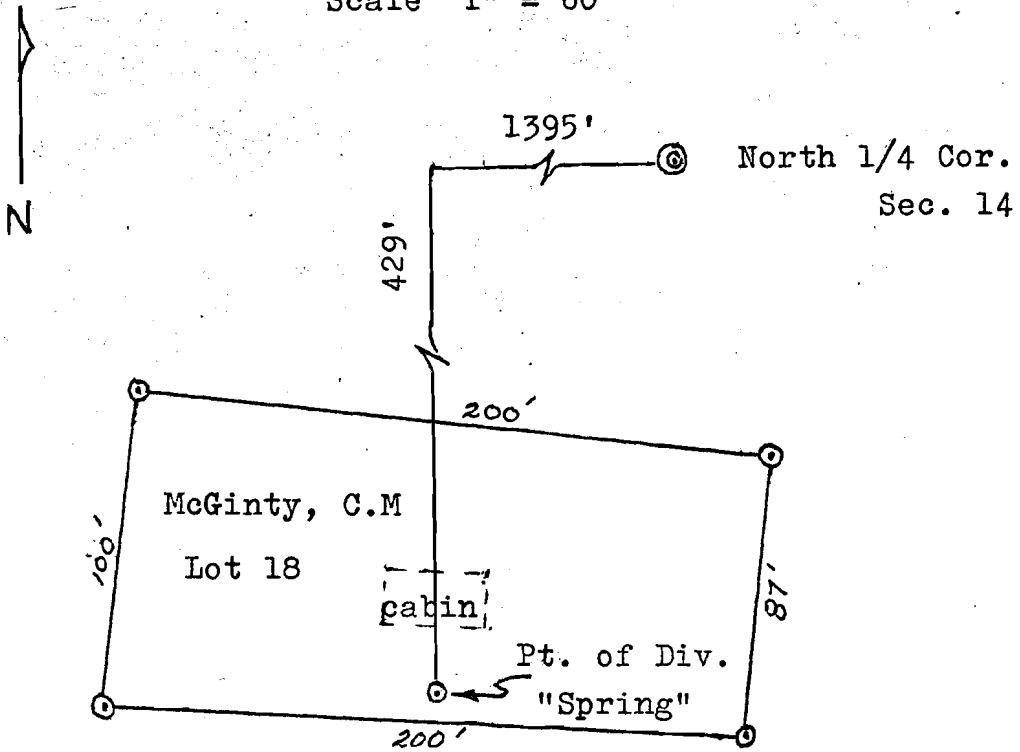

Block W Lot 18  
East Side Summer Homes  
Lake of The Woods

**RECEIVED**  
DEC 28 1978  
WATER RESOURCES DEPT.  
SALEM, OREGON

Application No. 58208  
Permit No. 46966

upper 11. LK & Misc