


T. 14S., R. 11W., W.M.

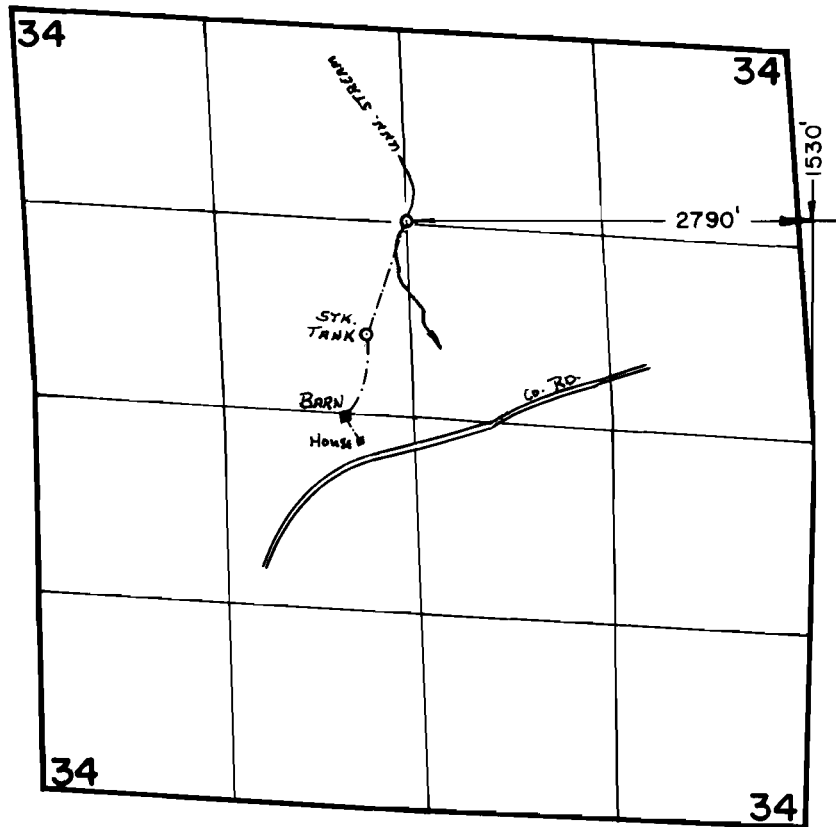

FINAL PROOF SURVEY UNDER

Application No. 54865... Permit No. 41365.....
IN NAME OF

LOUIS B. & EDWARD W. BRISTLIN

Surveyed Sept. 19, 1978, by J.S. Donaldson