
90684

T.13S., R.1W., W.M.

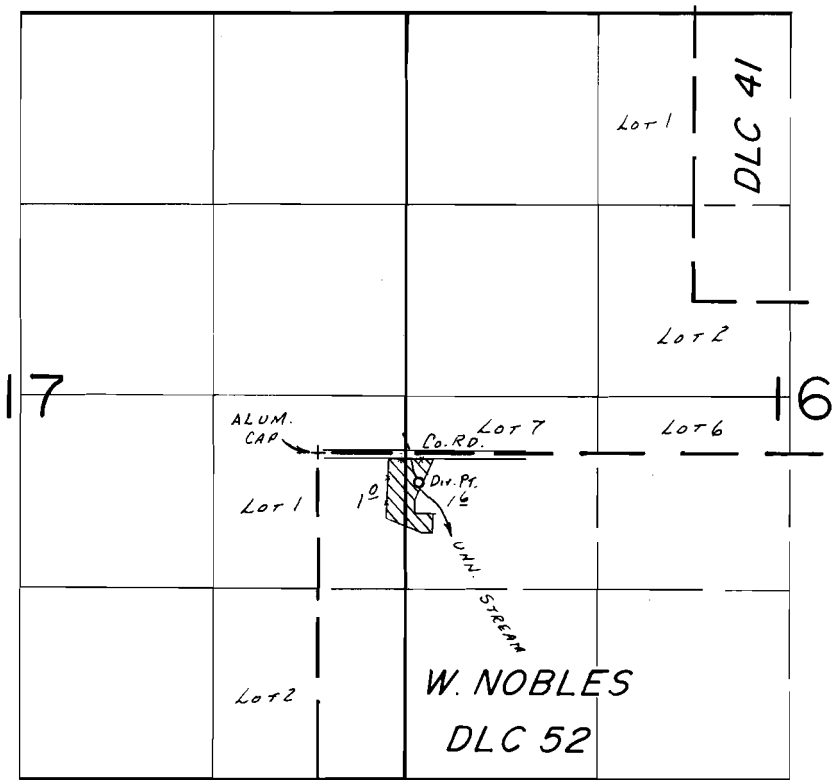

DIV. PT. LOC.: 200'S. & 700'E. FROM NW COR. W. NOBLES DLC 52

SCALE: 1" = 1320'

FINAL PROOF SURVEY

UNDER

Application No. 53361 **Permit No.** 39588

IN NAME OF

GORDON & KAREN TINGSTROM

Surveyed July 18, **19**86, **by** B.W. BISHOP

12/5/86
BWB

PTS-1986-B