


T.15S.,R.40E.,W.M.

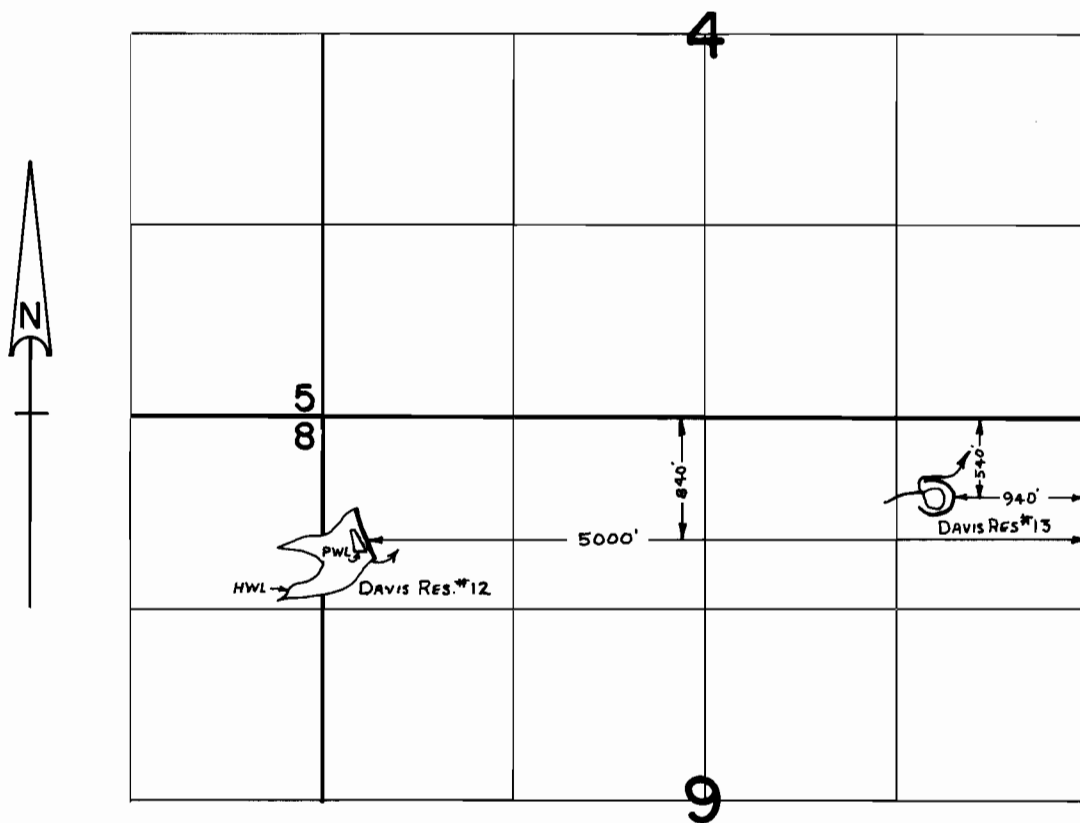

SCALE: 1"=1320'

FINAL PROOF SURVEY

UNDER

Application No. R-37352 Permit No. R-6718 Davis Res. 12
R-37353 R-6719 Davis Res. 13
 IN NAME OF _____

EUGENIE (MRS. GUSS) DAVIS.....

Surveyed Aug. 19, 1985, by L. M. TOLL.....

PTS 1985 V-A ^{LMT}