


T. 15S., R. 40E., W.M.

17



NW 1/4 SE 1/4

SCALE 1" = 400'

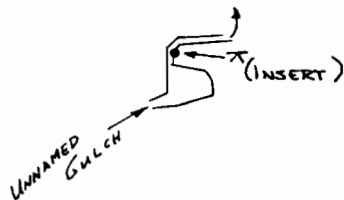

Div. Pt. Loc: 960'S. & 390'E. FROM CENTER COR. SEC. 17

SCALE 1" = 1320'

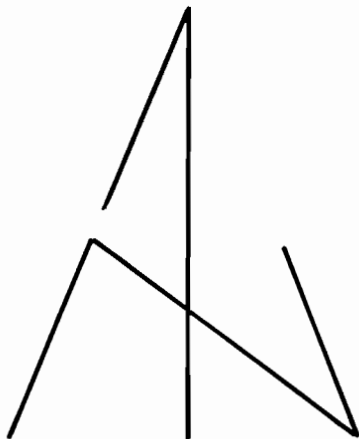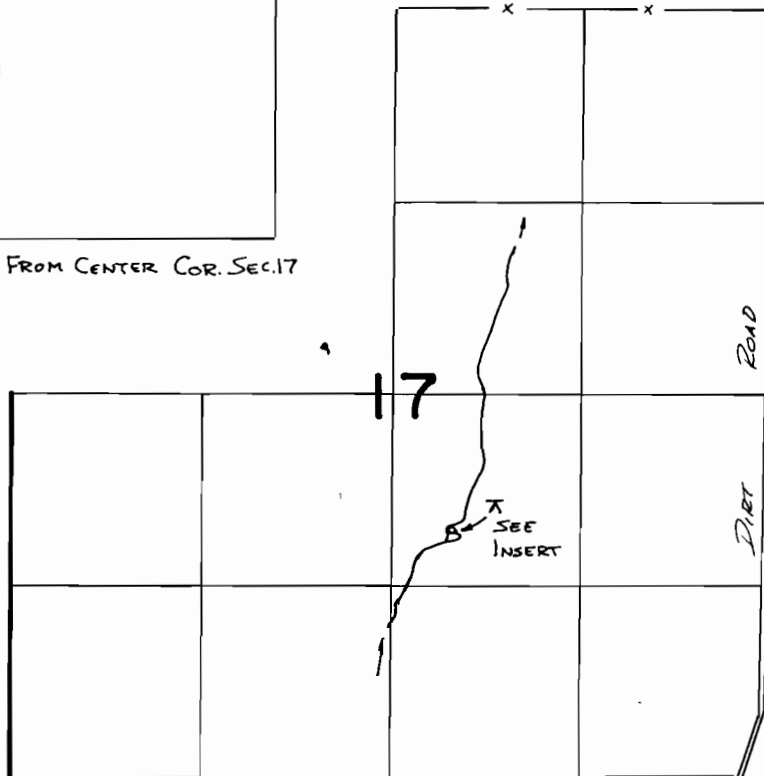


FINAL PROOF SURVEY
UNDER

Application No. **R:37351** Permit No. **R:6717**
IN NAME OF

DAVIS LAND & LIVESTOCK CO.

Surveyed 4-21 1988, by V.L. Church

T.15S.,R.40E.,W.M.

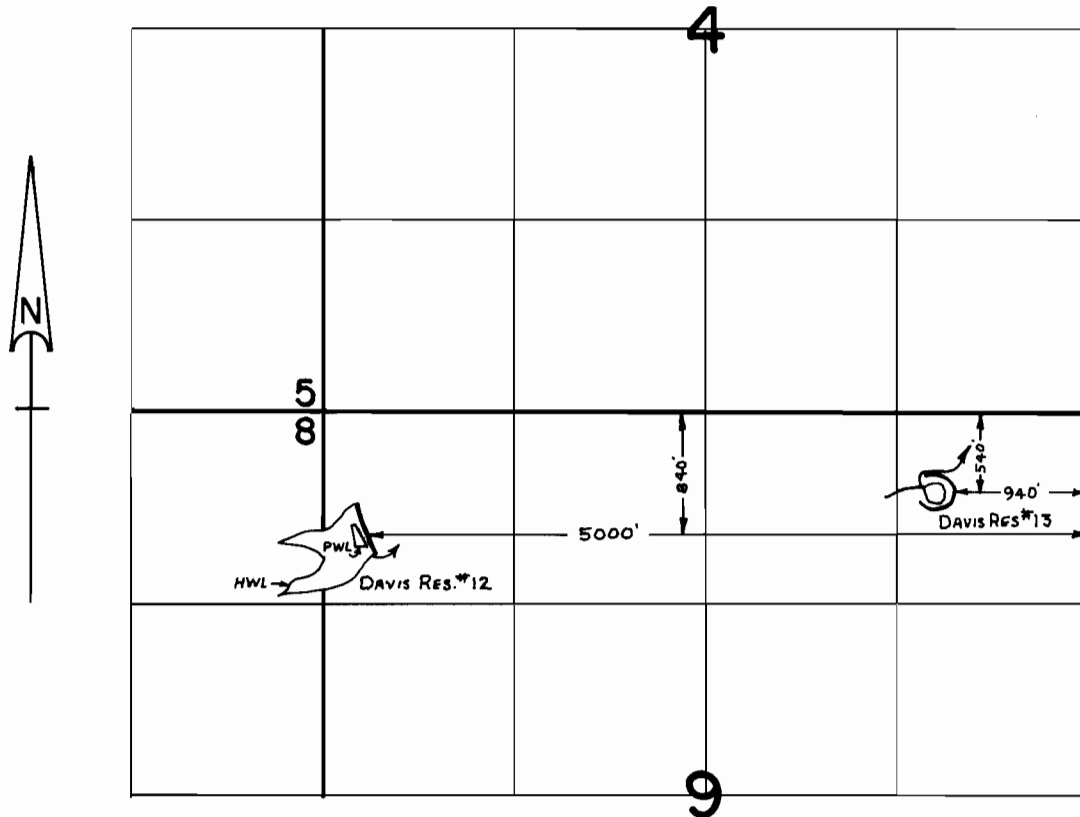

SCALE: 1"=1320'

FINAL PROOF SURVEY

UNDER

R-37352 R-6718 Davis Res. 12
Application No. R-37353 Permit No. R-6719 Davis Res. 13
IN NAME OF

EUGENIE (MRS. GUSS) DAVIS

Surveyed Aug. 19, 1985, by L. M. TOLL