
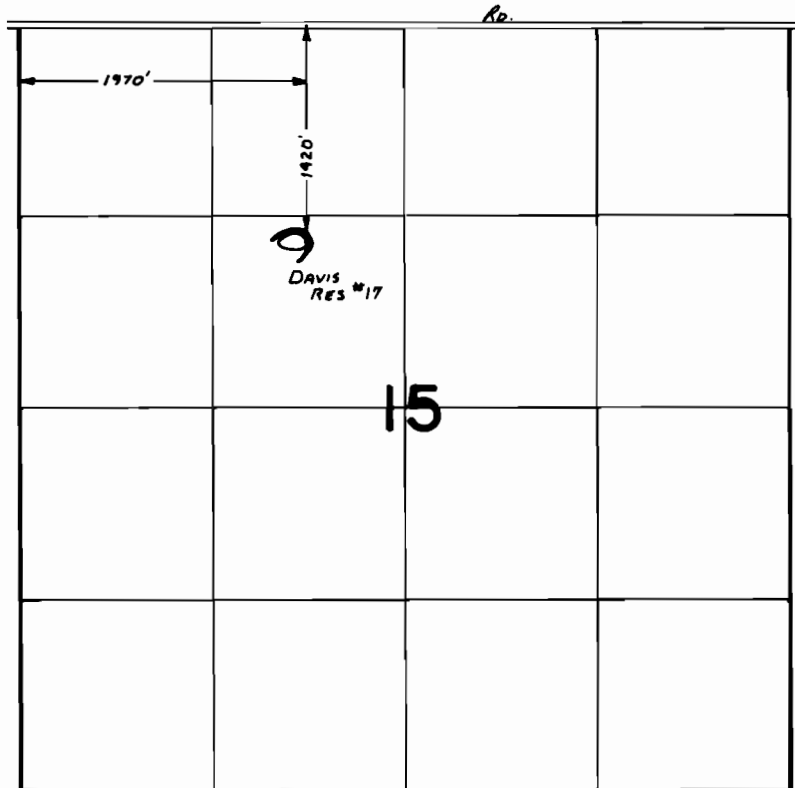


T.15S.,R.40E.,W.M.

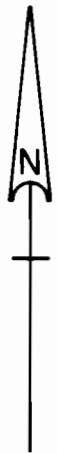

SCALE: 1" = 1320'

FINAL PROOF SURVEY
UNDER

Application No. R-37357 Permit No. R-6721.....
IN NAME OF

.....EUGENIE.....(MRS. GUSS) DAVIS.....

Surveyed Aug...8... 19.85, by L.M.TOLL.....