


T.38S.,R.40&41E.,W.M.

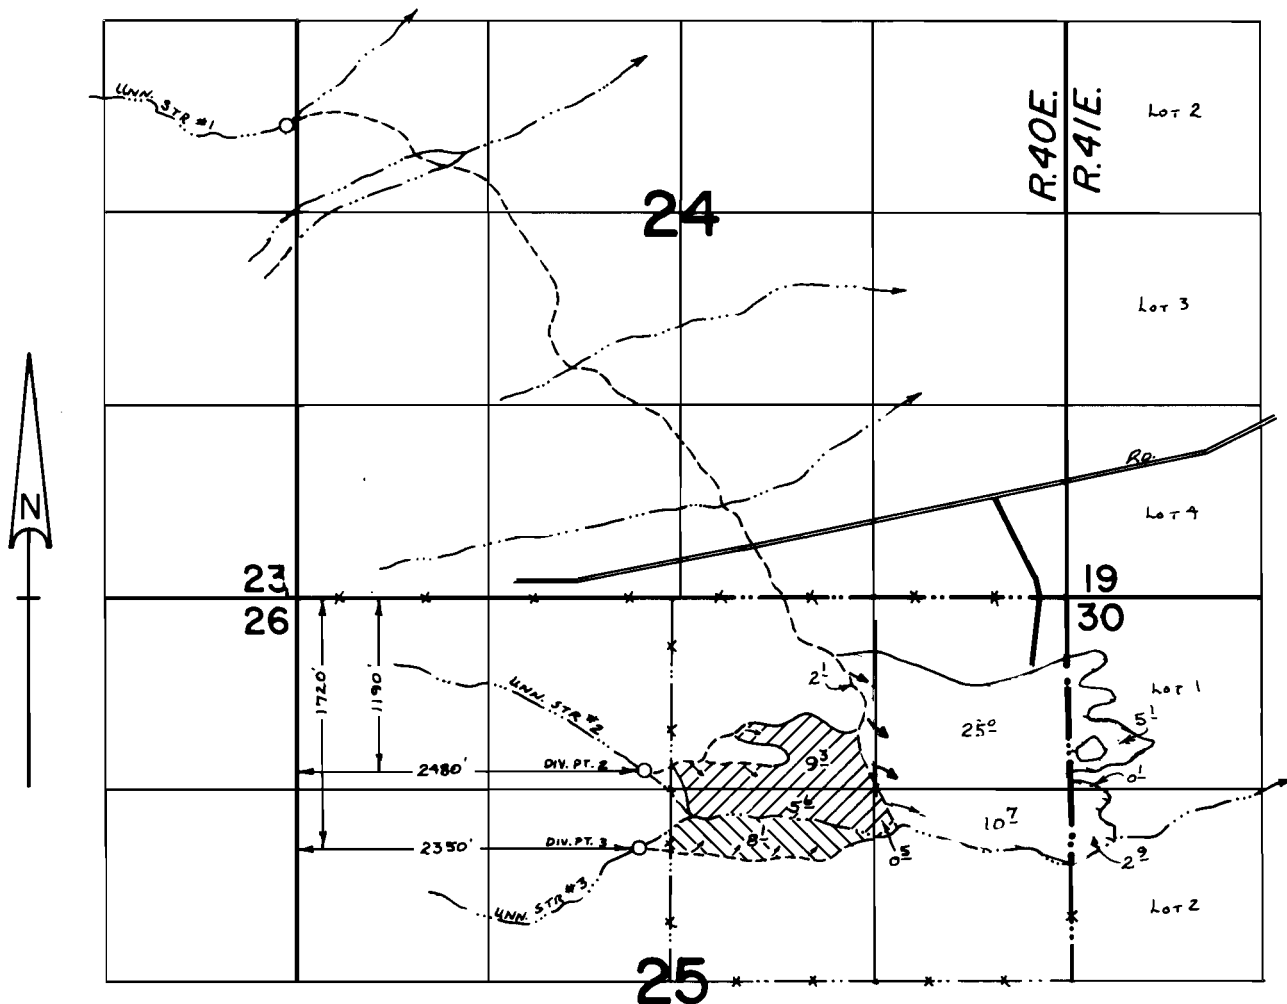

SCALE: 1" = 1320'



- from Unnamed Stream No. 2
- from Unnamed Stream No. 3

FINAL PROOF SURVEY **UNDER**

Application No. 42139 Permit No. 31513
IN NAME OF

JOHN STODDART

Surveyed July 25, 1985, by J. M. TOLL

REVISED 4/15/87 LHN

41045-278-276 L

LT