


T.33S.,R.39E.,W.M.

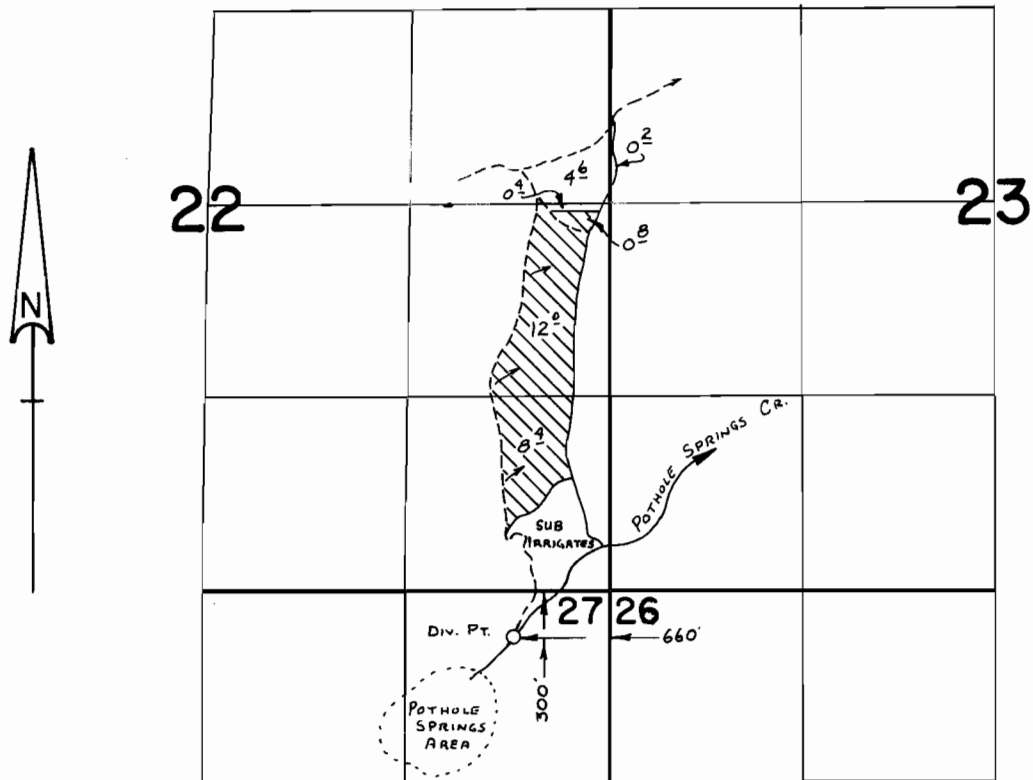

SCALE: 1" = 1320'

**FINAL PROOF SURVEY**  
UNDER

Application No. 47931 Permit No. 35905  
IN NAME OF

STODDART RANCHES, INC.

Surveyed July 17, 1985, by L. M. TOLL

41045-278-262R *MT*