


T.17S.,R.47E.,W.M.

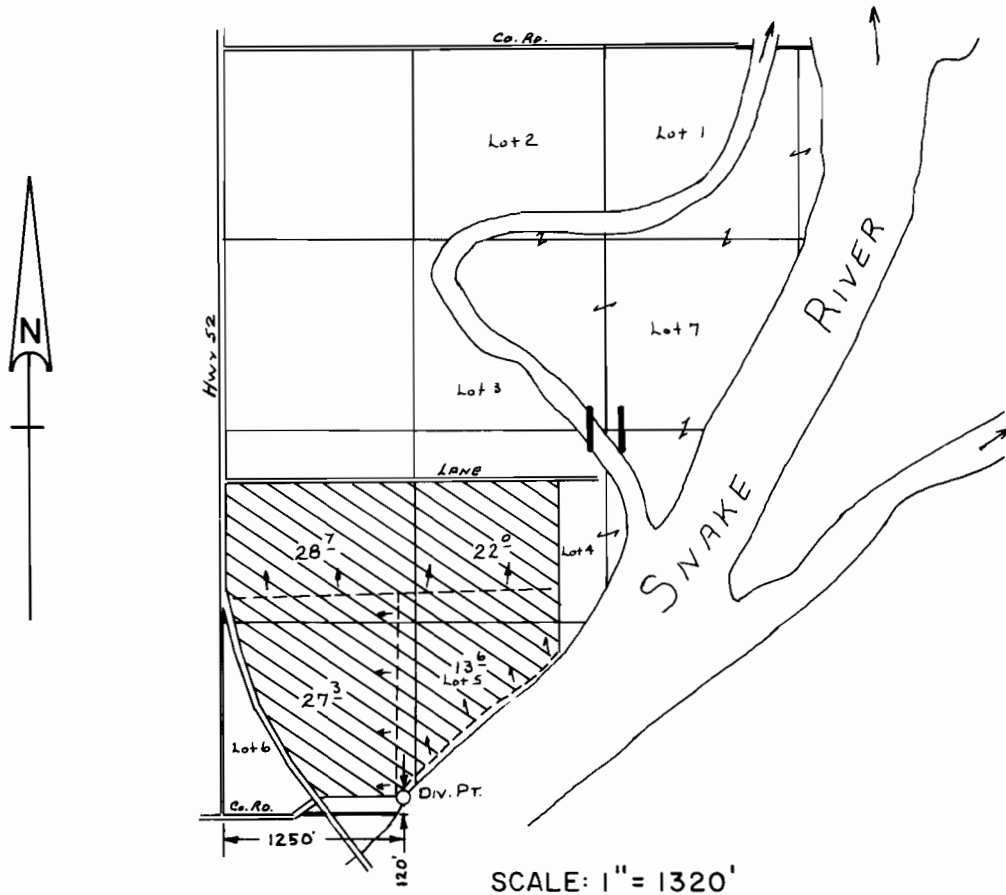

FINAL PROOF SURVEY
UNDER

Application No. 58589.. Permit No. 4416Q.....
IN NAME OF

.....LEO OLTMAN.....

Surveyed Aug.....1... 1985., by L.M.TOLL.....