


T.30S.,R.46E.,W.M.

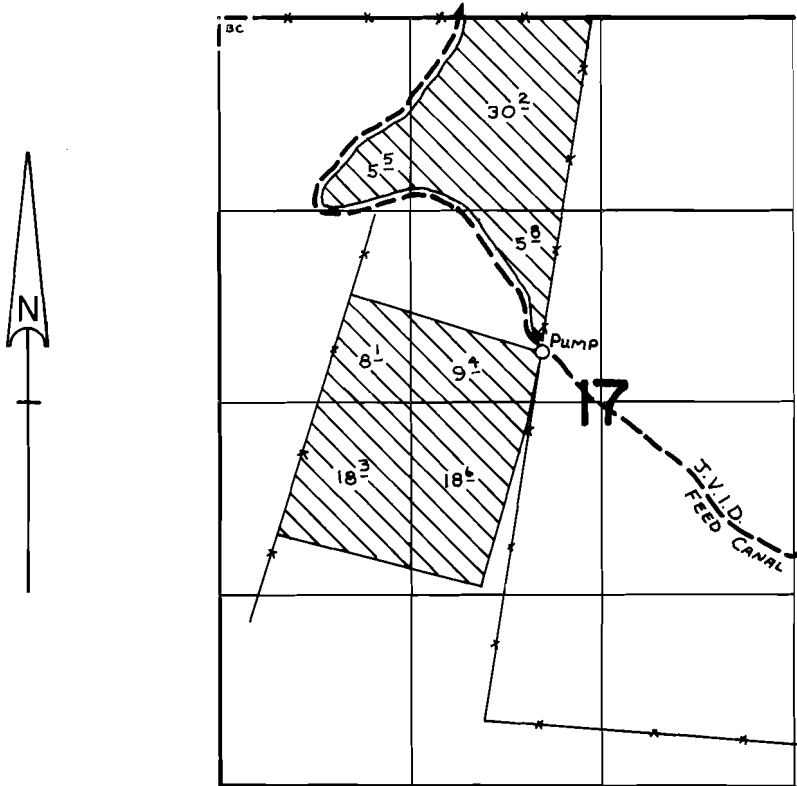

DIV. PT. LOC: 810' S. & 590' W. FROM N.E. CORNER SEC. 13, T. 30 S., R. 46 W., W.M.

SCALE: 1" = 1320'

## FINAL PROOF SURVEY UNDER

Application No. 62982.. Permit No. 46948.....  
IN NAME OF

MARION BOB WROTEN

Surveyed Oct. 16, 1985, by L. M. TOLL