


T.30S.,R.46E.,W.M.

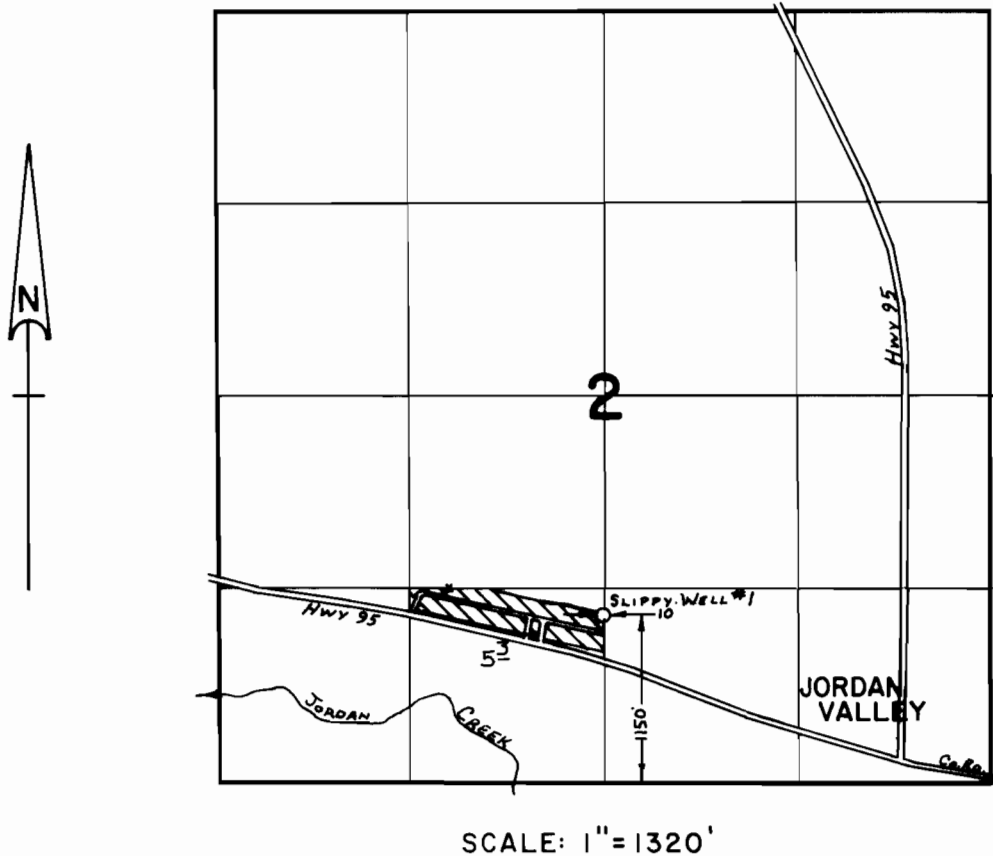

FINAL PROOF SURVEY
UNDER

Application No. G-5980. Permit No. G-5736.....
IN NAME OF

DARRELL SLIPPY.....

Surveyed July 26, 1985, by L. M. TOLL.....