


T. 30S., R. 46 E., W. M.

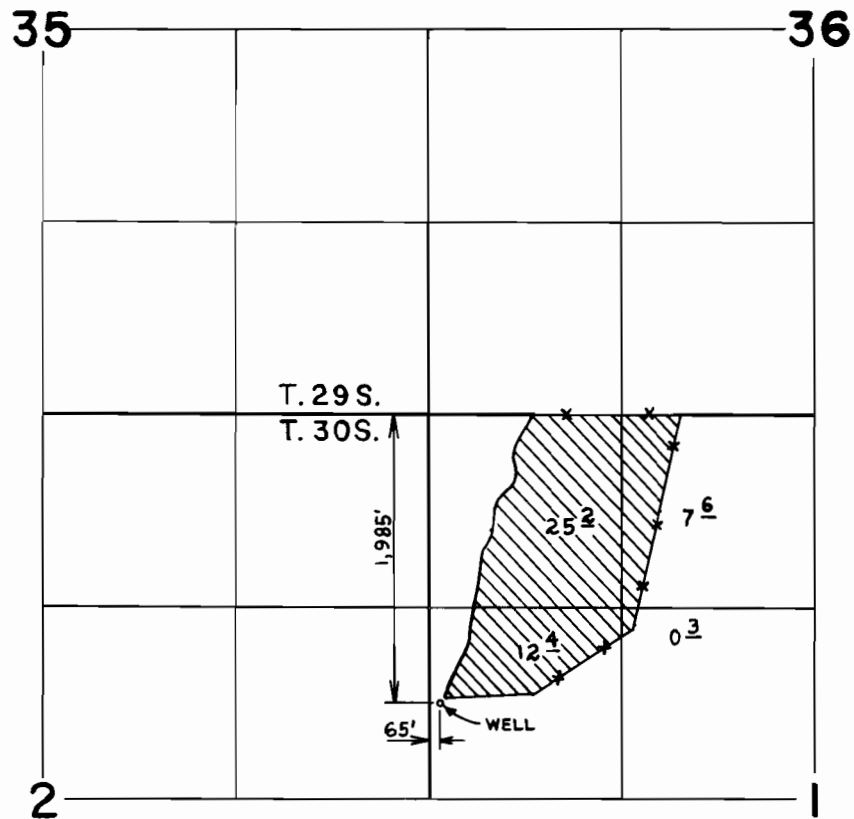

SCALE: 4"=1 mile

FINAL PROOF SURVEY
UNDER

Application No. ~~G-6987~~ Permit No. ~~G-6493~~
IN NAME OF

OLIVER WENDELL COLLINS

Surveyed JULY 26, 1985, by L. TOLL