


# T.14S., R.38&39E., W.M.

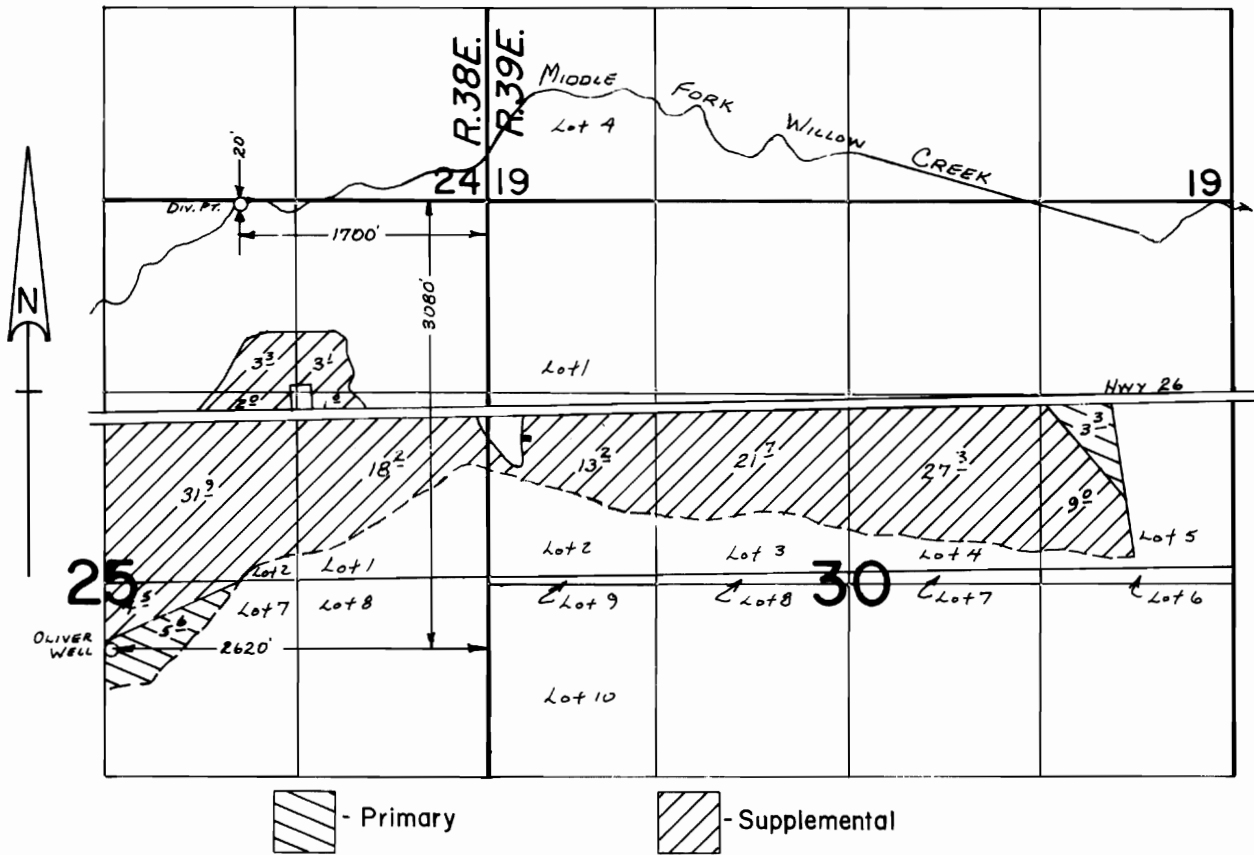

SCALE: 1" = 1320'

## FINAL PROOF SURVEY UNDER

Transfer No. 4304  
 Application No. G-7268 Permit No. G-6740  
 IN NAME OF

FLYING "O" CATTLE CO., INC.

Surveyed Sept. 30, 1985, by L. M. TOLL