


T. 17 S., R. 44 E., WM

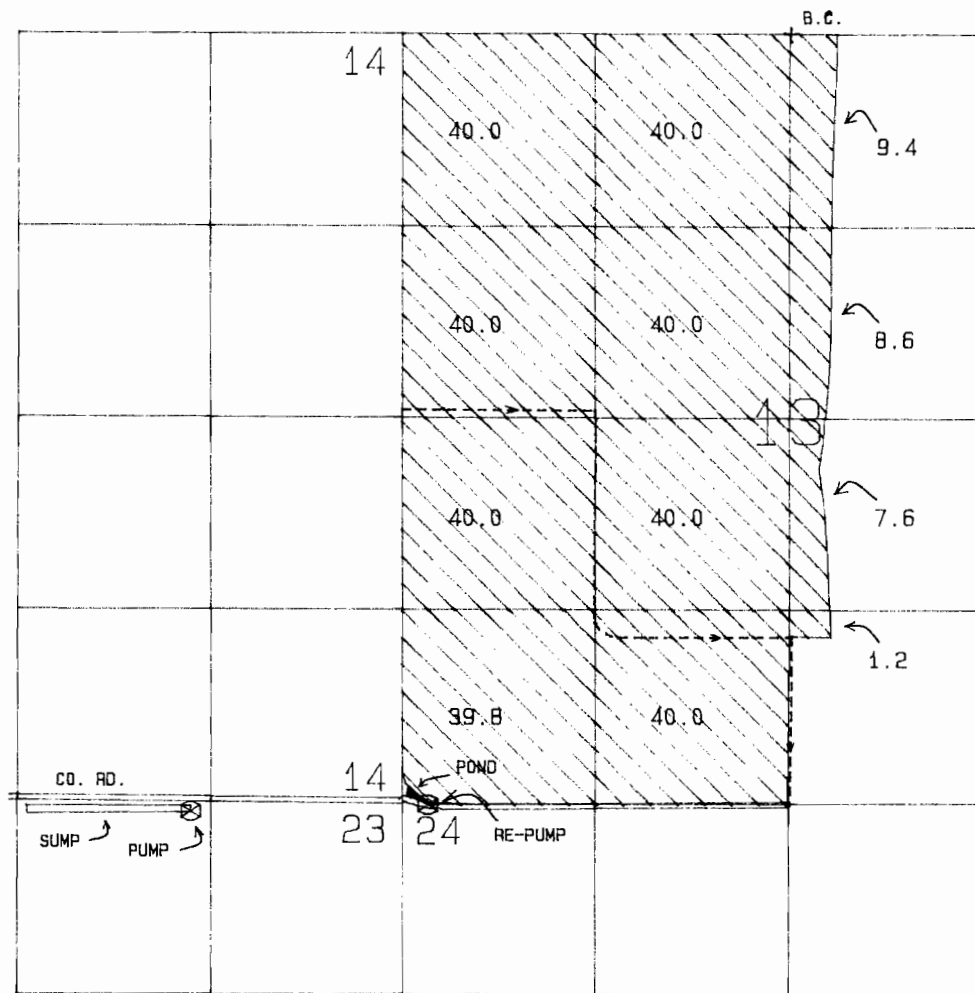

SUMP LOCATED: 60 FT SOUTH AND 1440 FT WEST FROM  
THE NORTHEAST CORNER OF SECTION 23.

SCALE 1 IN = 1320 FT

FINAL PROOF SURVEY  
UNDER

APPLICATION NO.: G-9459      PERMIT NO.: G-8702  
IN THE NAME OF

O. T. FARMS, A PARTNERSHIP

SURVEYED MAY 27, 1986      BY: L. M. TOLL

COMPUTER DRAFTED: JCL  
PHOTO 41045-478-66R  
PTS-1986-V-A