


# T.5S. R.1W. W.M.

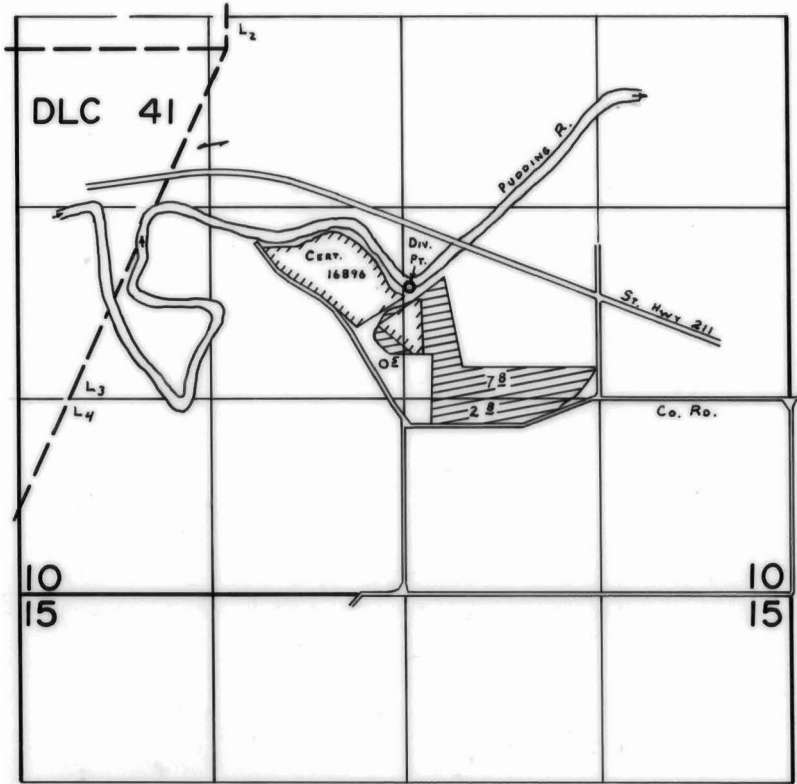

Div. Pt. Loc: 550'S.  $\frac{1}{4}$  40'E. fr. C.  $\frac{1}{4}$  Cor. Sec. 10.

## FINAL PROOF SURVEY UNDER

Application No. 53791... Permit No. 40161.....  
IN NAME OF

.....YAKOV OVCHINNIKOV.....

Surveyed July 1..... 1980, by C. L. Hughes.....