


- file copy -

T. 6 S. R. 2 W. W. M.

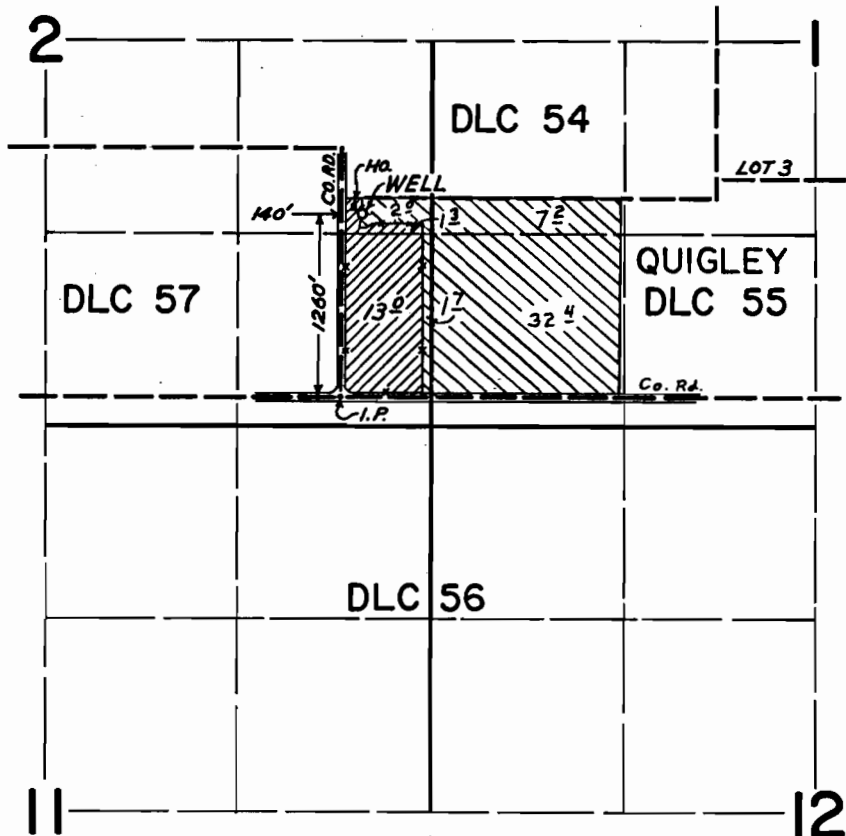

FINAL PROOF SURVEY UNDER

G-7246 G-6650
 Application No. ~~G-3892~~ Permit No. ~~G-3658~~
 IN NAME OF



..... JOSEPH ZELLNER

Surveyed JULY 30, 1971, by GREG BACA
 APR 25 1979 L. H. NUNN