


T. 6S. R. 1W. W.M.

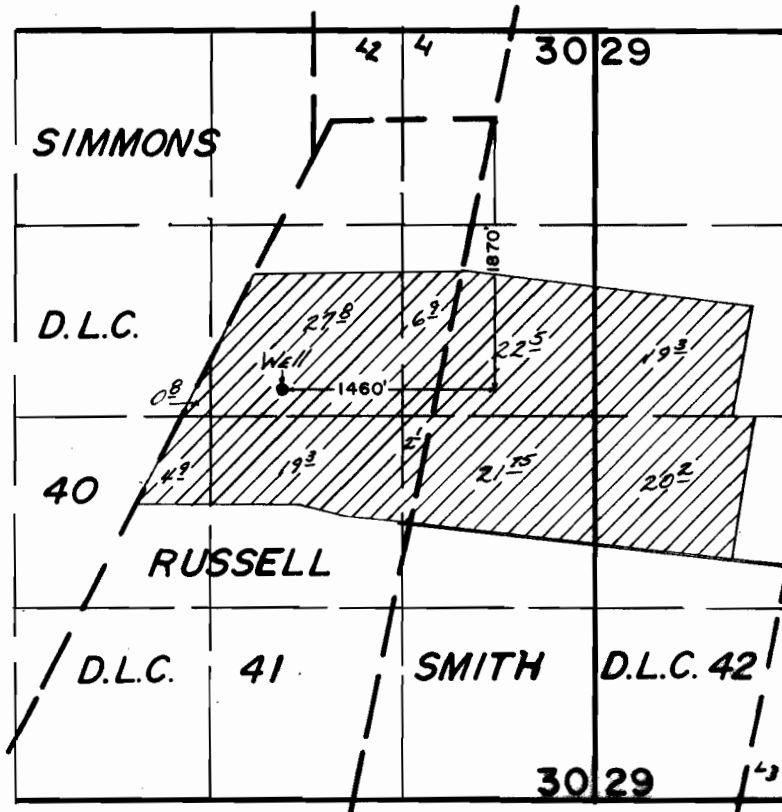

FINAL PROOF SURVEY UNDER

Application No. G-6584 Permit No. G-6667
IN NAME OF

ALBERT E. SCHARER

Surveyed Oct. 2, 1979, by C.R. RODRIGUEZ