


T.6S. R.3W., W.M.

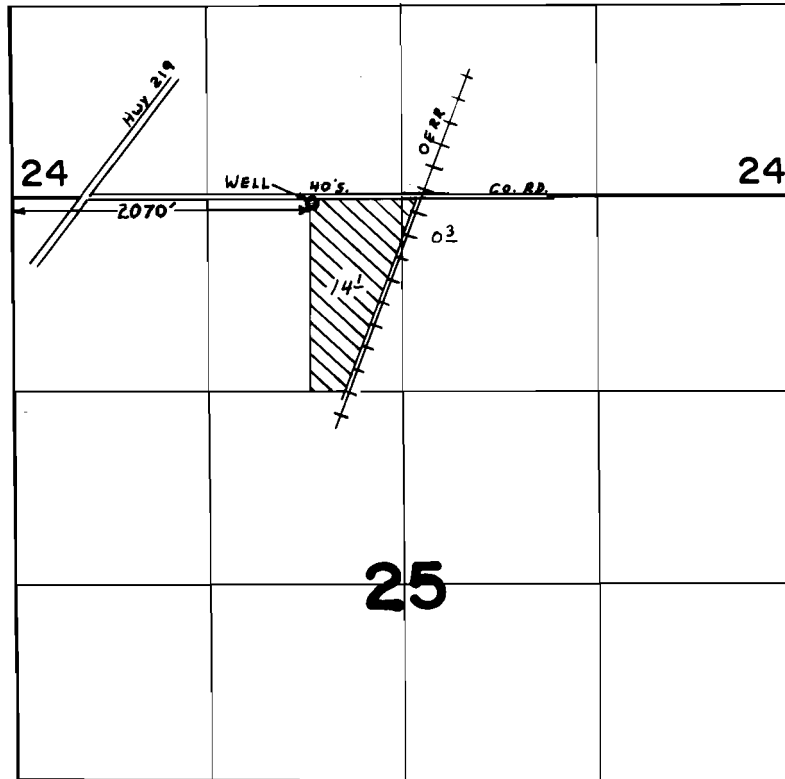

FINAL PROOF SURVEY UNDER

Application No. G-8127.... Permit No. G-7502...
IN NAME OF

Barbara O'Halloran & Thomas A. O'Halloran, Jr.
.....

Surveyed APR. 24. 1979., by L. H. NUNN.....