


T.I.S.R.4E.W.M.

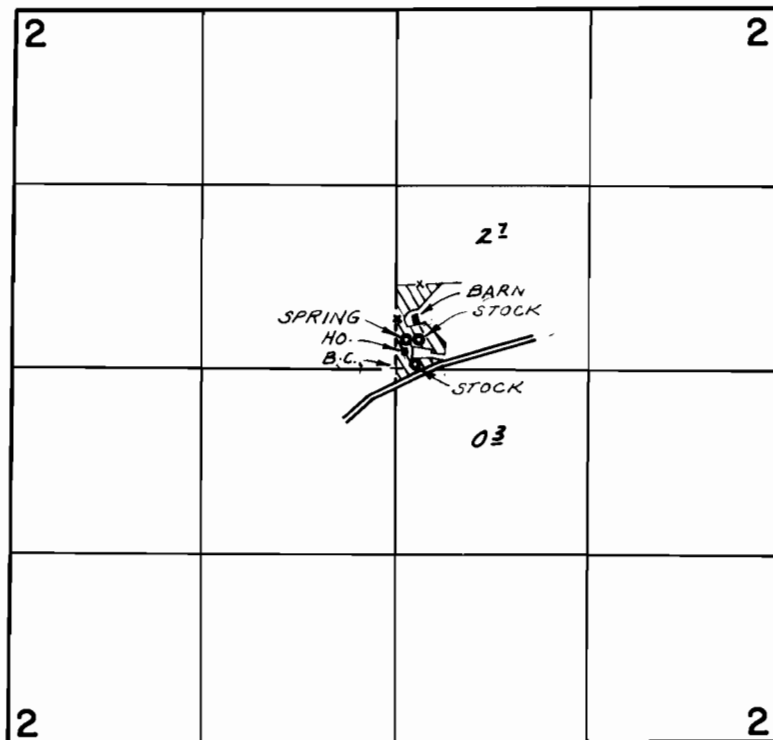

SPRING LOC: 200' N. & 70' E. FROM CEN. SEC. 2

FINAL PROOF SURVEY
UNDER

Application No. 52581... Permit No. 39817...
IN NAME OF

WILLIAM EYVONNE MARBLE

Surveyed JAN. 7... 1980, by R.G. MUCKEN