


T. 3S. R. 10W. WM.

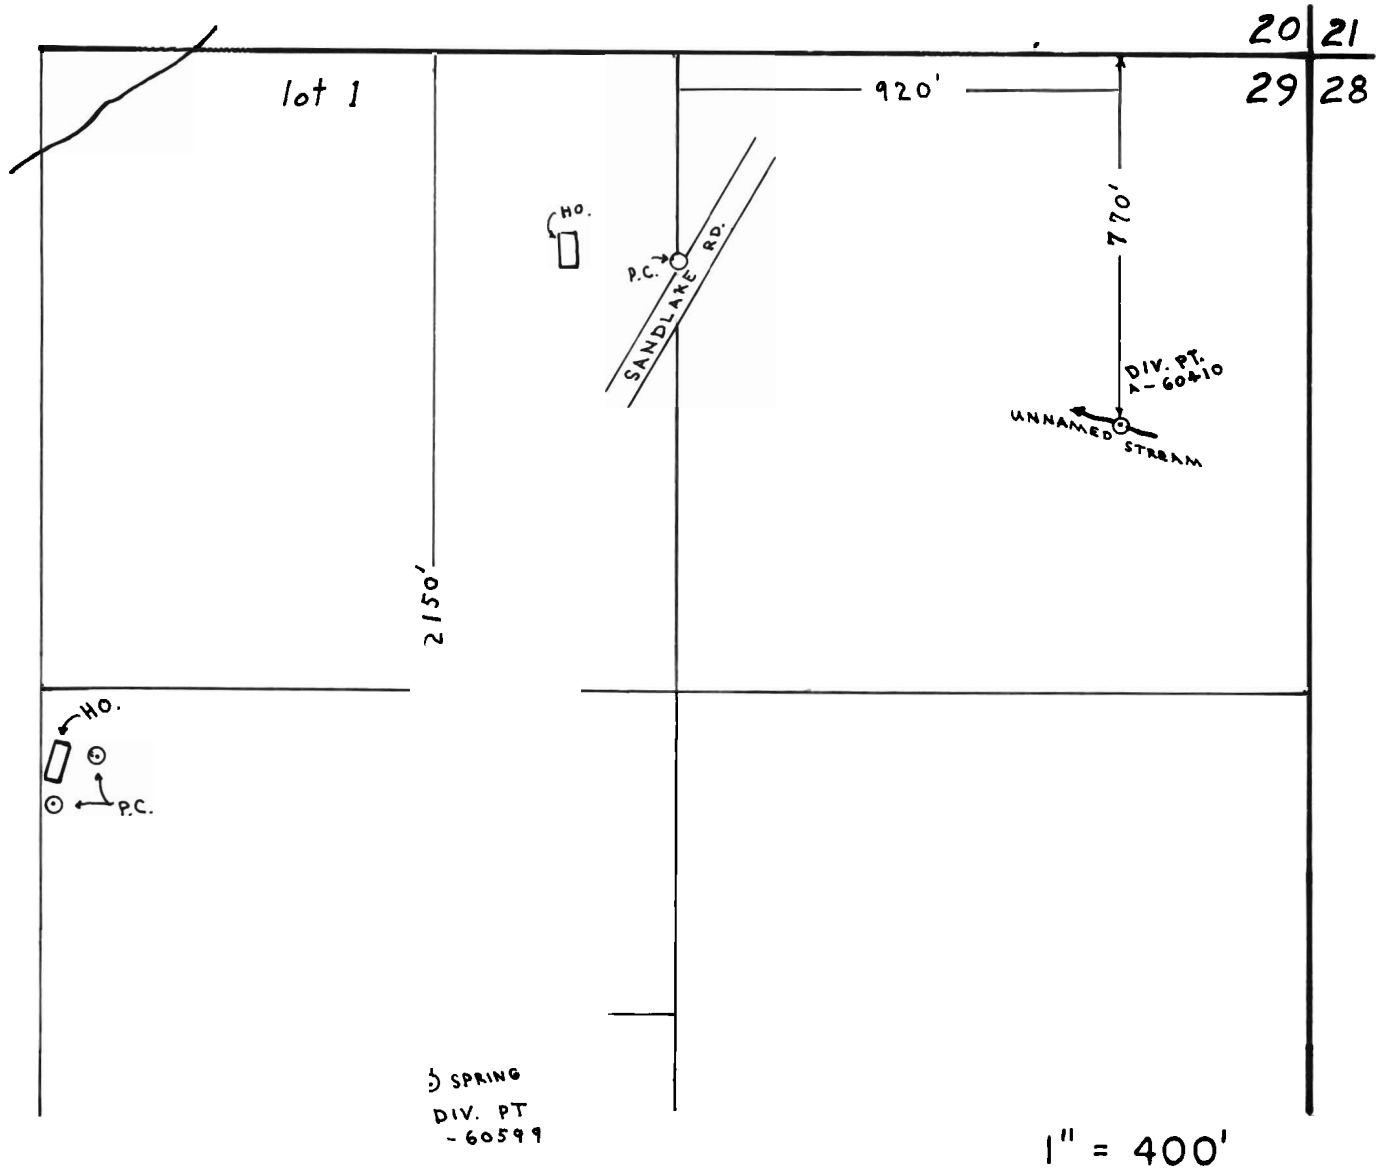

FINAL PROOF SURVEY
UNDER

Application No. 60410 60599 Permit No. 45010 45011
IN NAME OF

AMOS FRY

Surveyed OCT. 12. 1983, by P. A. G. I. E. R. P...