


T. 3S. R. 10W. WM.

20 | 21
29 | 28

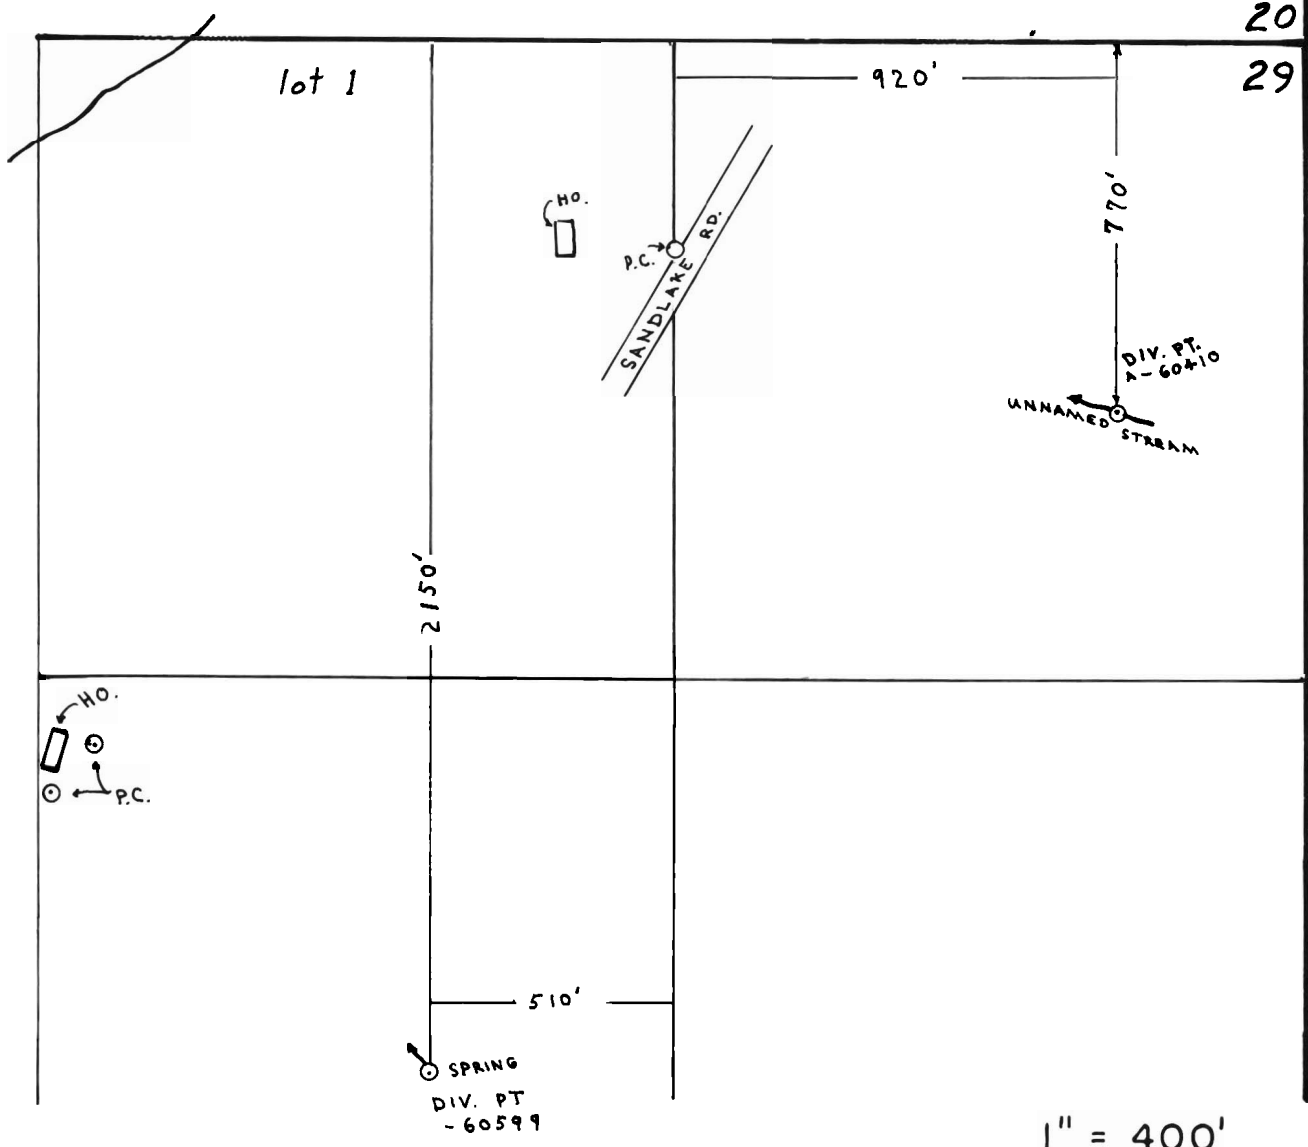

FINAL PROOF SURVEY
UNDER

Application No. 60410 Permit No. 45010
60599 45011.....
IN NAME OF

AMOS FRY

Surveyed OCT. 12. 1983, by P.A.G.T.E.R., P.