



T. 586 N., R. 35 E., W. M.

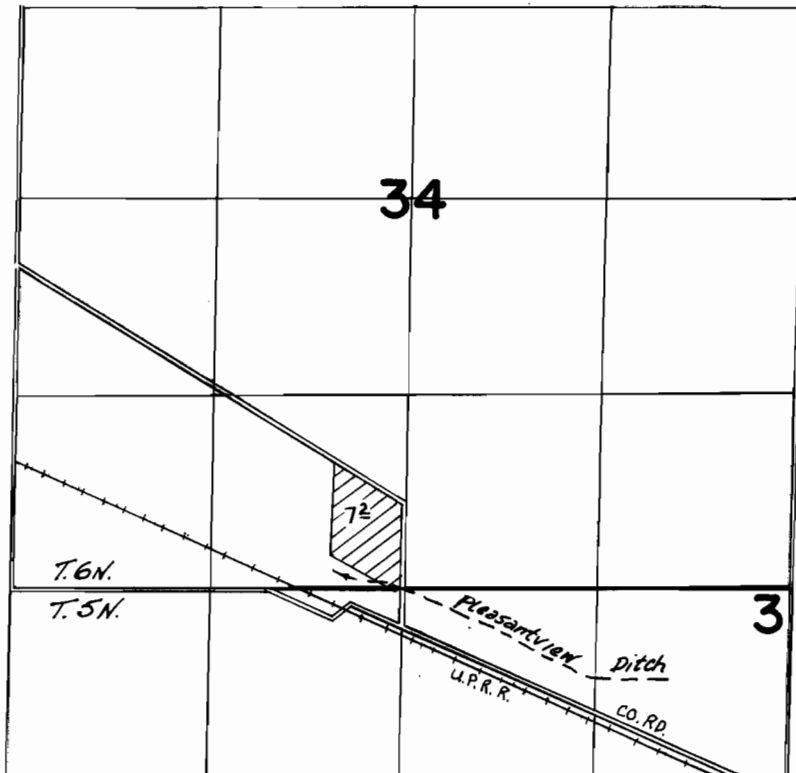

Scale 1"=1320'



FINAL PROOF SURVEY UNDER

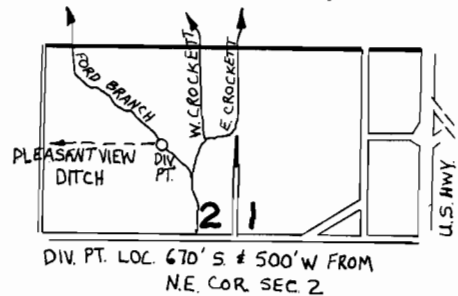

Application No. 64924... Permit No. 47624....
IN NAME OF

MARVIN SAMS

Surveyed May 8 1986, by J. Sauter