


6-7618
RECEIVED
AUG 3 1987
56391

T. 5N., R. 35E., W. M.

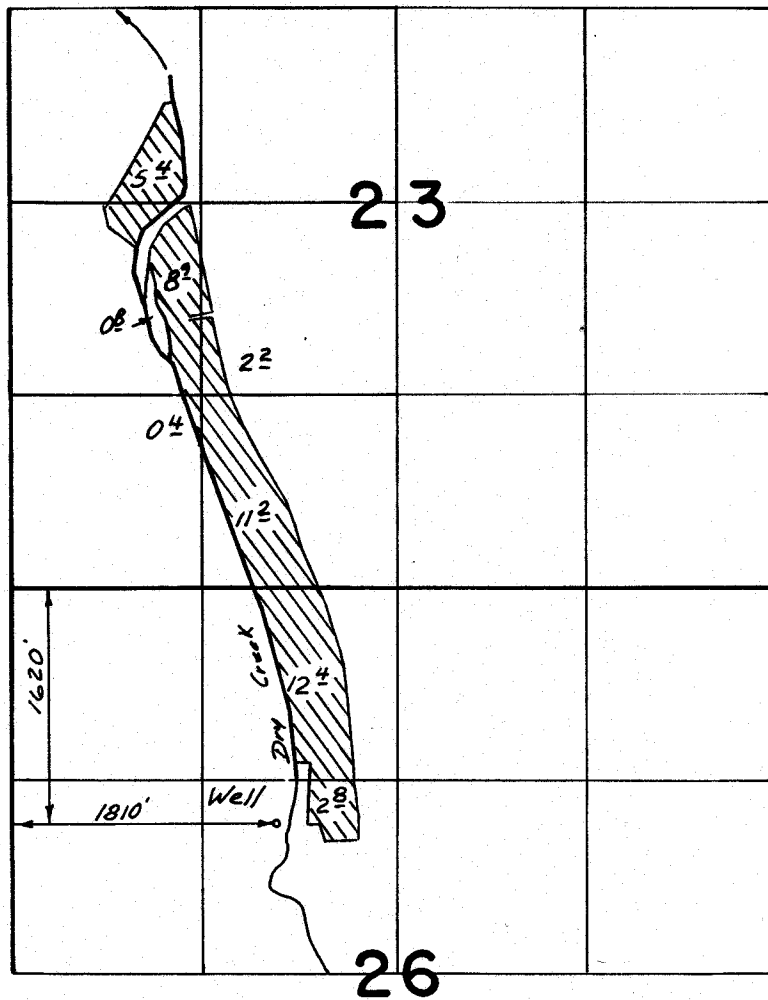

SCALE: 1" = 1320'

FINAL PROOF SURVEY
UNDER

Application No. **G:8376**. Permit No. **G:7618**....
IN NAME OF

BARNETT RUGG INC.

Surveyed **11-7**..... 19**84**., by **V. L. Shursh**.....

NZ-4F-146