


RECORDED
AUG 8 1987
56394

T.5 N., R.29 E., W.M.

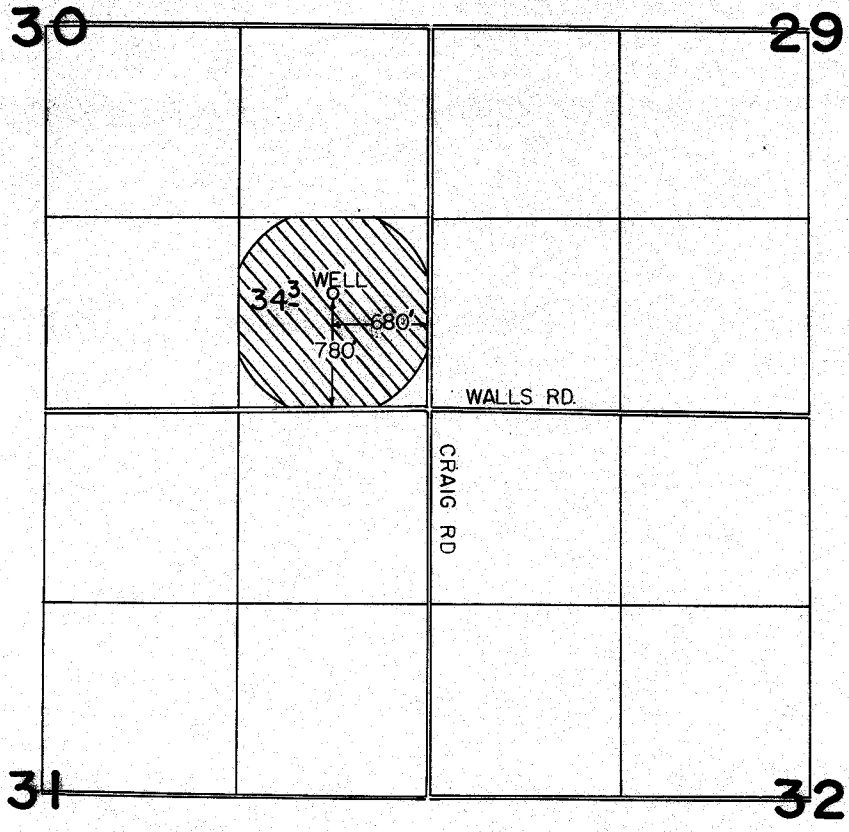

Scale 1" = 1320'



FINAL PROOF SURVEY UNDER

Application No. G.11209.. Permit No. G.10317.....
IN NAME OF

RONALD A. WILLIAMS & GERALD D. RAY

Surveyed March 4, 1986, by V. Church.....