




T. 1S., R. 2W., W.M.

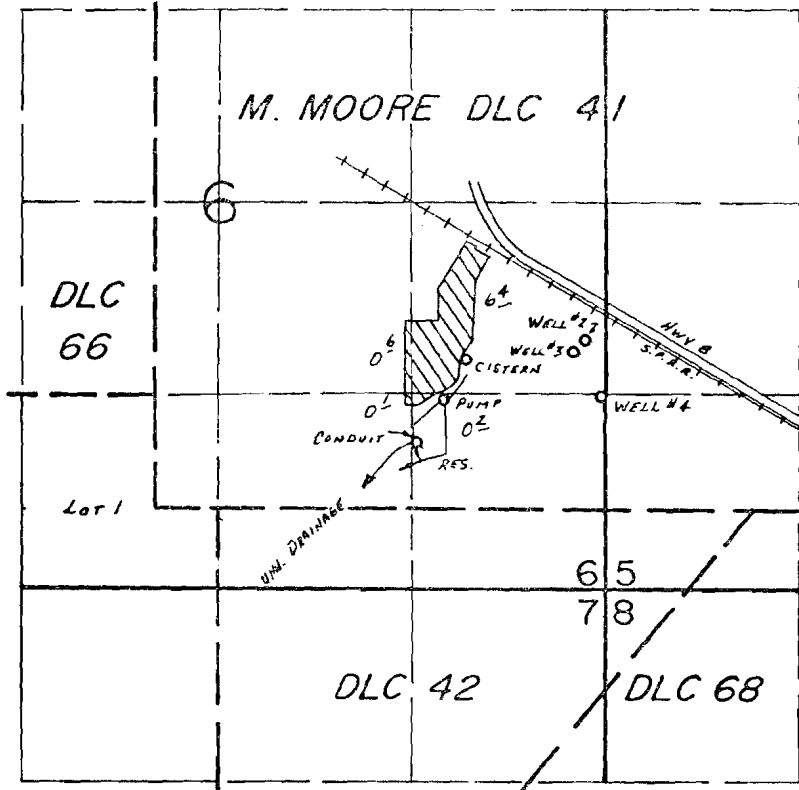

Div. Pt. Loc.: 460' N. & 1790' E., Well #2 Loc. 1150' N. & 2940' E.,  
 Well #3 Loc. 1070' N. & 2850' E., Well #4 Loc. 770' N. & 5050' E.,  
 ALL FROM THE SW COR. OF M. MOORE DLC 41.

SCALE: 1" = 1320'

**FINAL PROOF SURVEY**  
 UNDER

R-48860                      R-5805  
 48861                      35927 PRIMARY  
 Application No. G-5670 Permit No. G-4983 SUPPLEMENTAL  
 IN NAME OF

.....OREGON ROSES, INC. ....

Surveyed Aug. 19, 1986, by R.W. BISHOP.....

RECEIVED AUG 9 1987

2-11-87  
 848