


T. 138 & 14S., R. 5W., W.M.

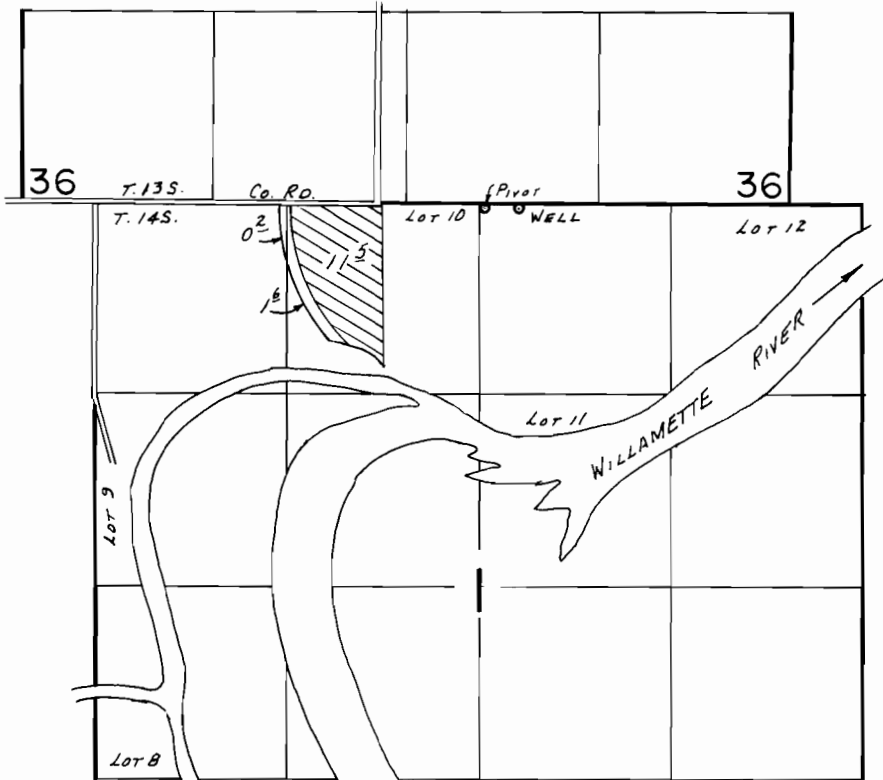

WELL LOC.: 30'S. & 2920'E. FROM NW. COR. SEC. 1

SCALE: 1" = 1320'

FINAL PROOF SURVEY UNDER

Application No. G:10960 Permit No. G:10062...
IN NAME OF

.....RAY TRENHOLM.....

Surveyed Aug. 3..... 1984, by L.M. TOLL.....