


T. 28 S., R. 14 W., W.M.

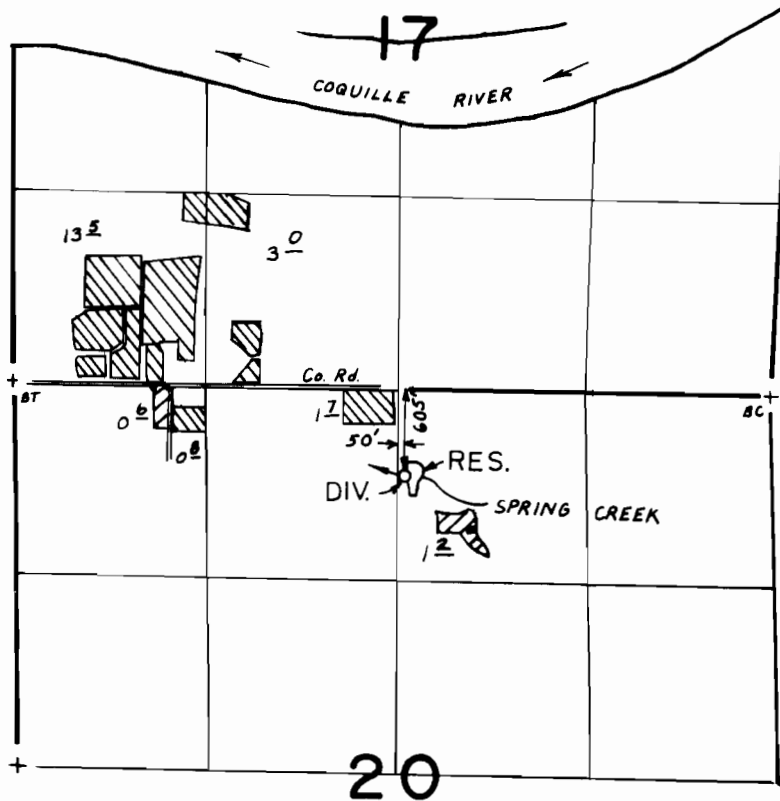

SCALE : 4" = 1 mile

-  PRIMARY IRRIGATION
-  SUPPLEMENTAL IRRIGATION

### FINAL PROOF SURVEY

UNDER

R-48441                      R-6751

48442                        42567

Application No. G-5571 Permit No. G-7861.....

IN NAME OF

Marvin R. Manes & DOROTHY M. BUTLER.....

Surveyed SEPT. 19 1984, by J.E. Cashion.....