


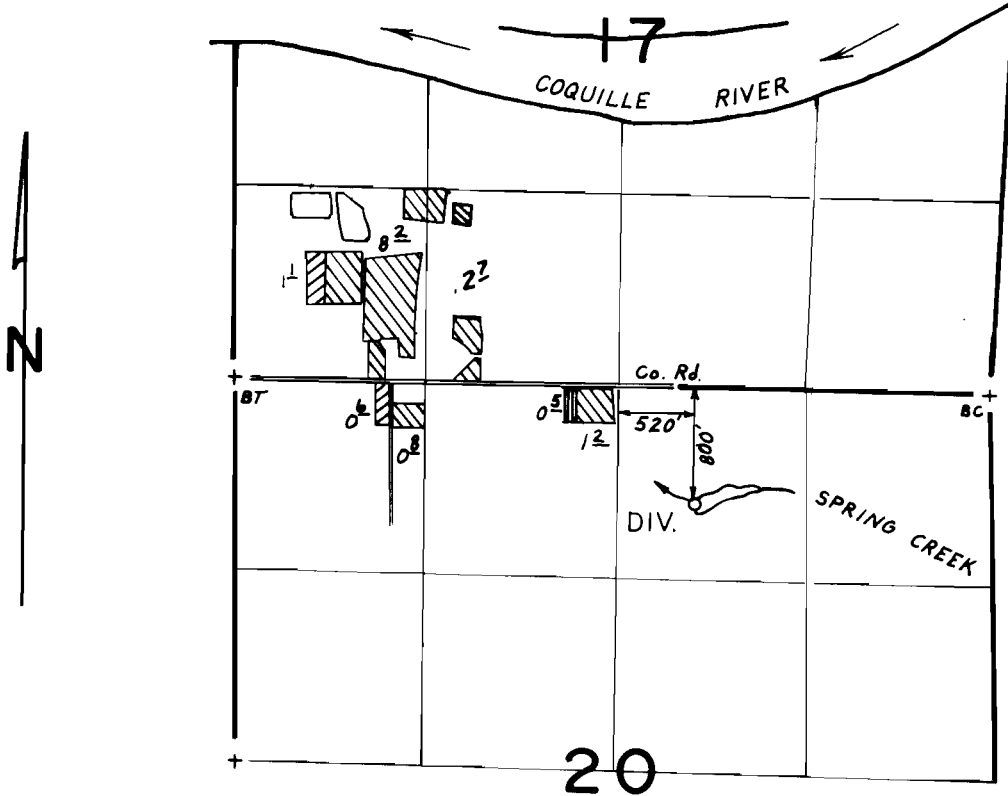


T. 28 S., R. 14 W., W.M.



-  SUPPL. HARVESTING
-  PRIM. HARVESTING
-  IRRIGATION, SUPPL. HARV.

SCALE: 4" = 1 mile

FROST PROTECTION ON ALL LAND

FINAL PROOF SURVEY UNDER

Application No. 46528... Permit No. 34762.....
IN NAME OF

Marvin R. Manes & DOROTHY M. BUTLER.....

Surveyed SEPT. 19 1984, by J. E. CASHION.....