


T.28S., R.14W., W.M.

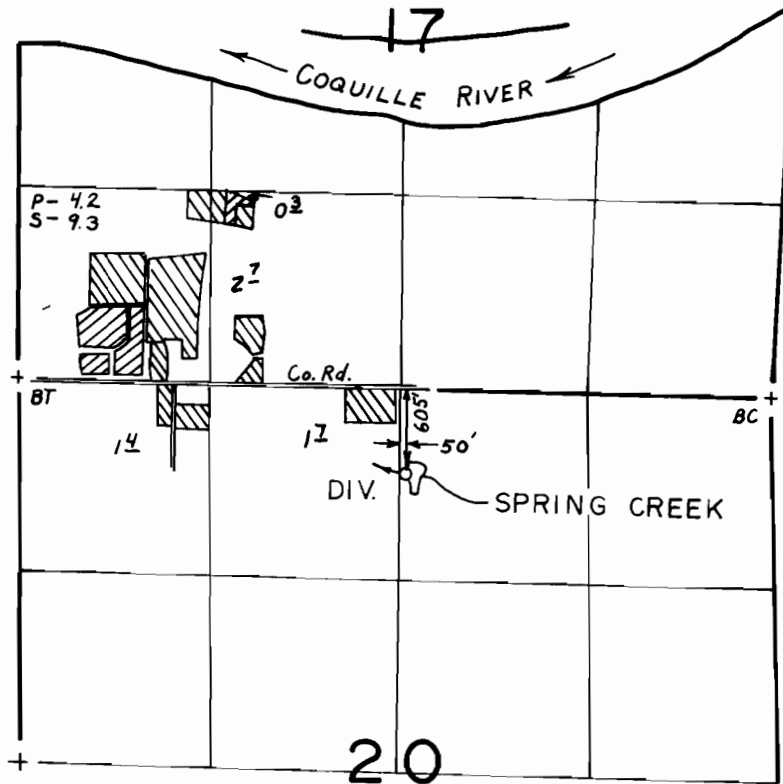

SCALE: 4" = 1 mile

 PRIMARY HARVESTING

 SUPPLEMENTAL HARVEST.

FINAL PROOF SURVEY

UNDER

R-48441 R-6751
48442 42567

Application No. G-5571 Permit No. G-7861...

IN NAME OF

Marvin R. Manes & DOROTHY M. BUTLER...

Surveyed SEP.T. 19 1984., by L. E. Cashier...