


T.22 S. R.7W. W.M.

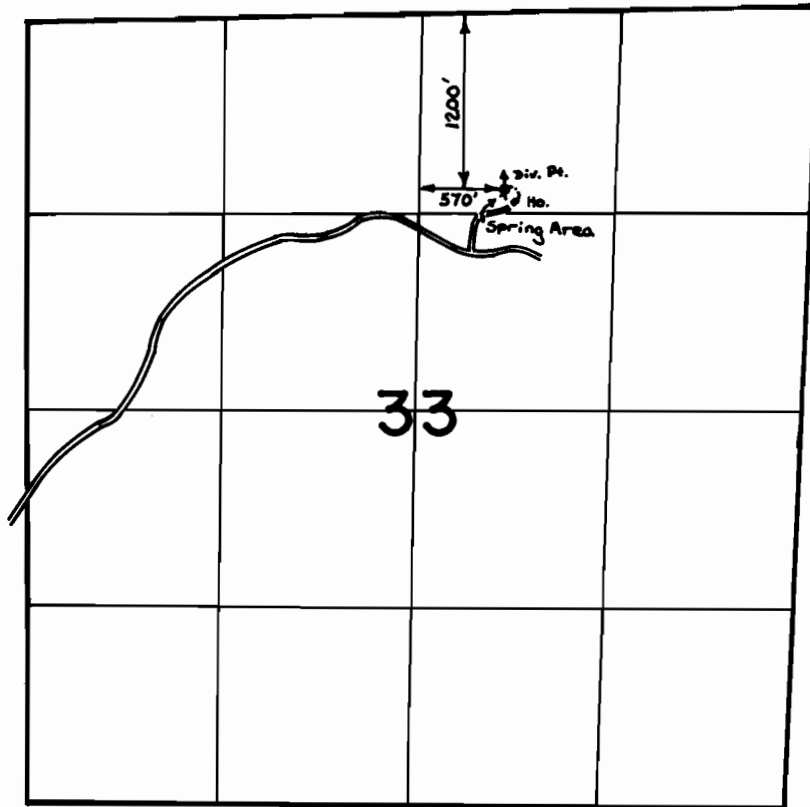

SCALE: 4" = 1 mile

FINAL PROOF SURVEY
UNDER

Application No. 57843 Permit No. 44176
IN NAME OF

ROBERT AND BARBARA BEISELL

Surveyed Aug. 23, 1979, by S. Donaldson