


T.22S., R.5 W., W.M.

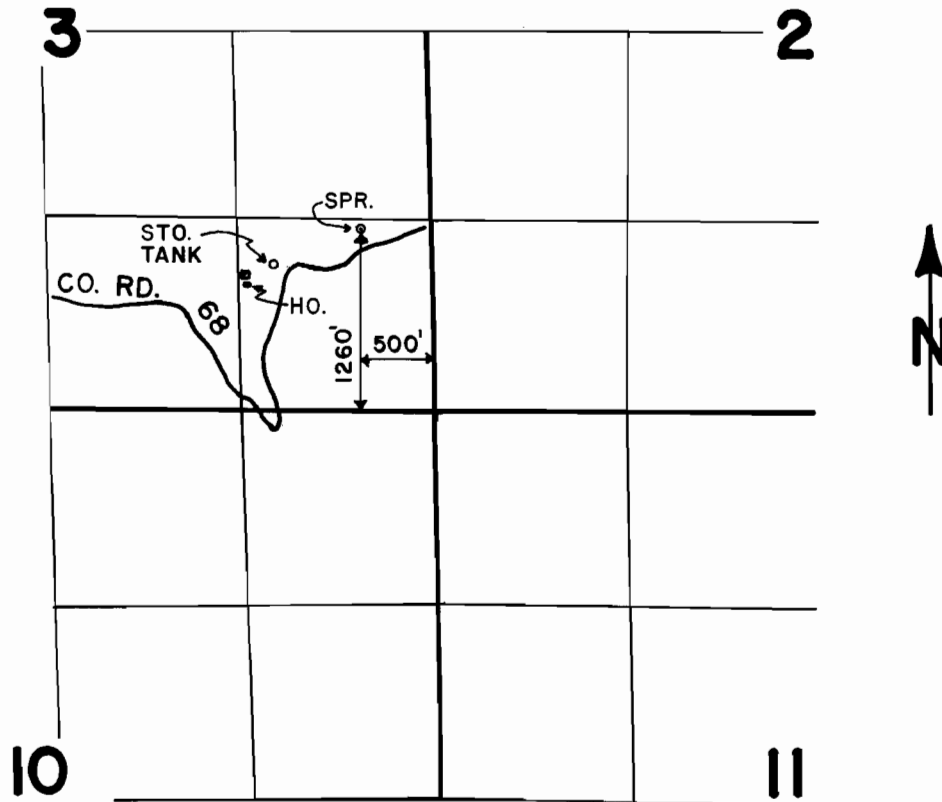

SCALE: 1" = 1320'

FINAL PROOF SURVEY
UNDER

Application No. 58389.. Permit No. 44069.....
IN NAME OF

.....**WILLIAM JOSEPH BECK**.....

Surveyed OCT. 20, 1986, by J. M. SCHMORDE