


T. 26 S., R. 6 W., W.M.

SEC. 27

NW 1/4 SE 1/4

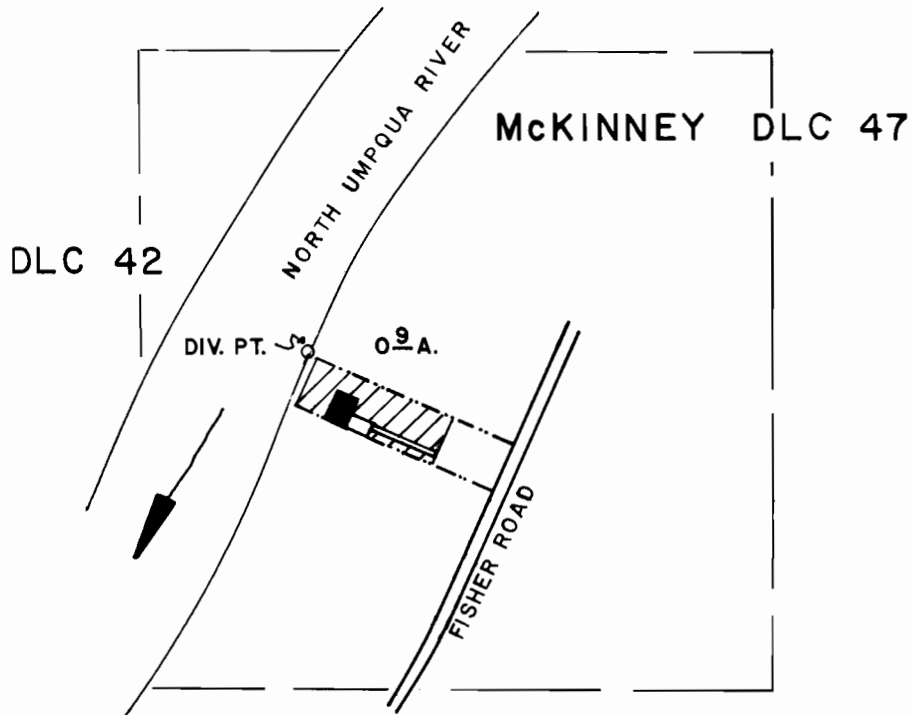

DIV. LOCATED 2010' N. & 350' E. OF S. 1/4 COR. SECTION 27.

SCALE: 1" = 400'



FINAL PROOF SURVEY
UNDER

Application No. 68111..... Permit No. 48641.....
IN NAME OF

ROOS, STEPHEN & MELINDA

Surveyed OCT. 3 1985, by J.M. SCHMORDE