
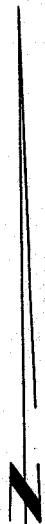


39277 SC415

T. 13S., R. 28E., W. M.

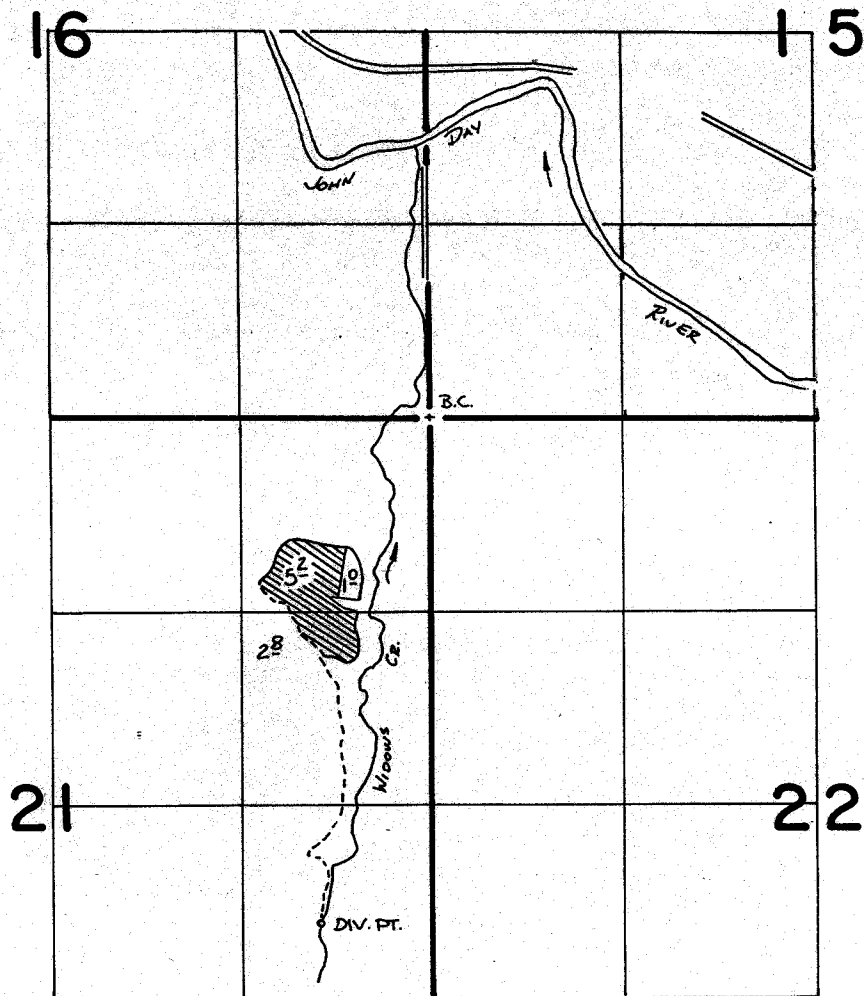

SCALE 1" = 1320'

Div. Pt. Loc: 3440'S. & 770'W. FROM NE COR.

SEC. 21

FINAL PROOF SURVEY

UNDER

Application No. **52152**. Permit No. **39277**....
IN NAME OF

G. B. SWAN

Surveyed ~~8-8~~ 19~~84~~84, by ~~P. Pater~~ P. Pater
3-20 86 V. Church