



P-45368  
C-56417

# T. 15 S. R. 32 E. W.M.

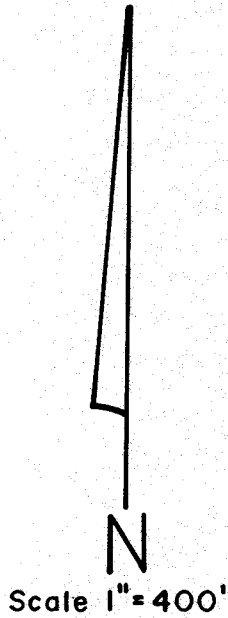

## SW1/4 SE1/4 SECTION 28

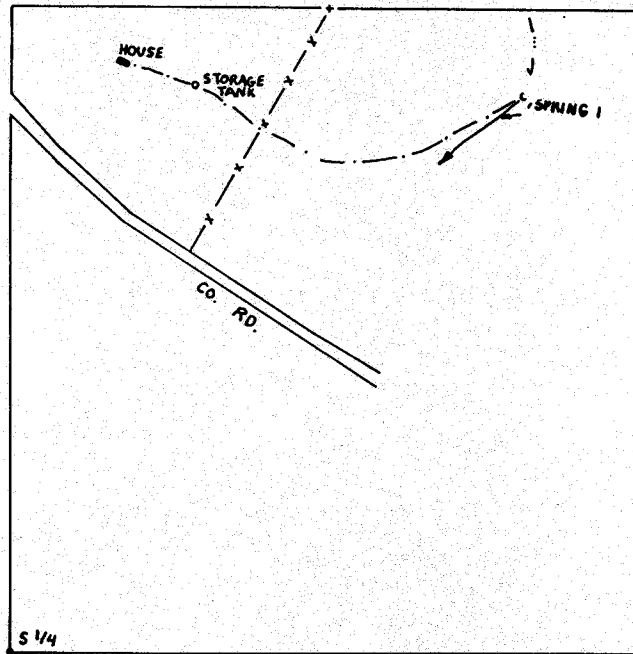

SPRING 1 LOC. 1140' N. & 1070' E. FROM S. 1/4 COR. SEC. 28

## FINAL PROOF SURVEY UNDER

Application No. 60856.. Permit No. 45368.....  
IN NAME OF

.....**CLAUDE JAMES STERLING**.....

Surveyed April 9... 1986., by L.M. Toll.....