


P-48313  
C-56418

T. 9S., R. 35 $\frac{1}{2}$ E., W. M.

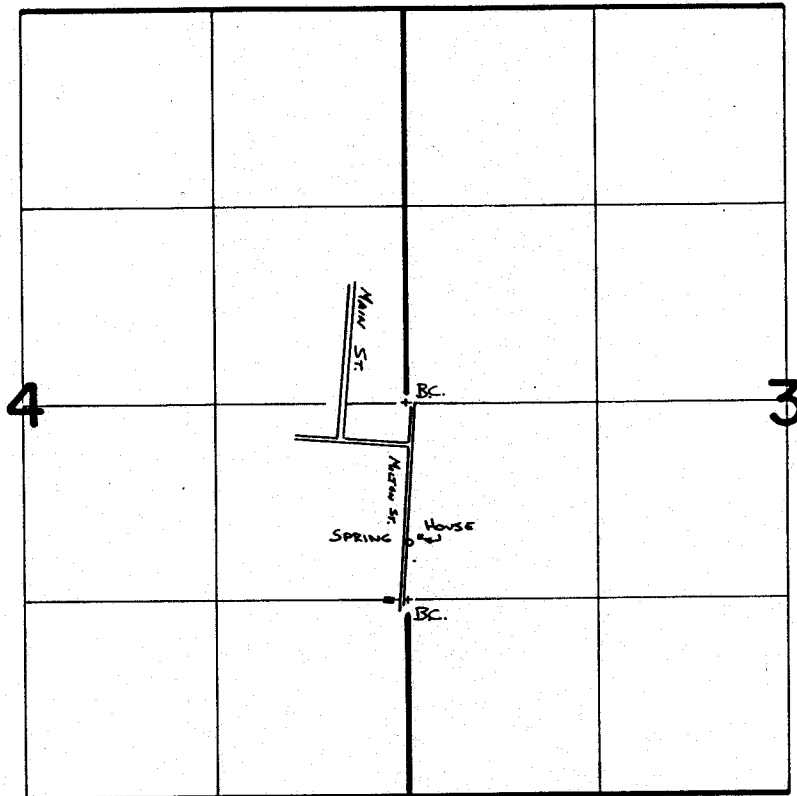

SCALE 1" = 1320'

SPRING LOC: 950'S. & 10'E. FROM W $\frac{1}{4}$  COR. SEC 3

**FINAL PROOF SURVEY**  
UNDER

Application No. **66098** Permit No. **48313**....  
IN NAME OF

**ROBERT W., CAROL L., DWIGHT A. & GREGORY H. DITTY**

Surveyed *4-21*..... 19*86*., by *L.M. TALL*.....