


# T. 39 S., R. 2 W., W.M.

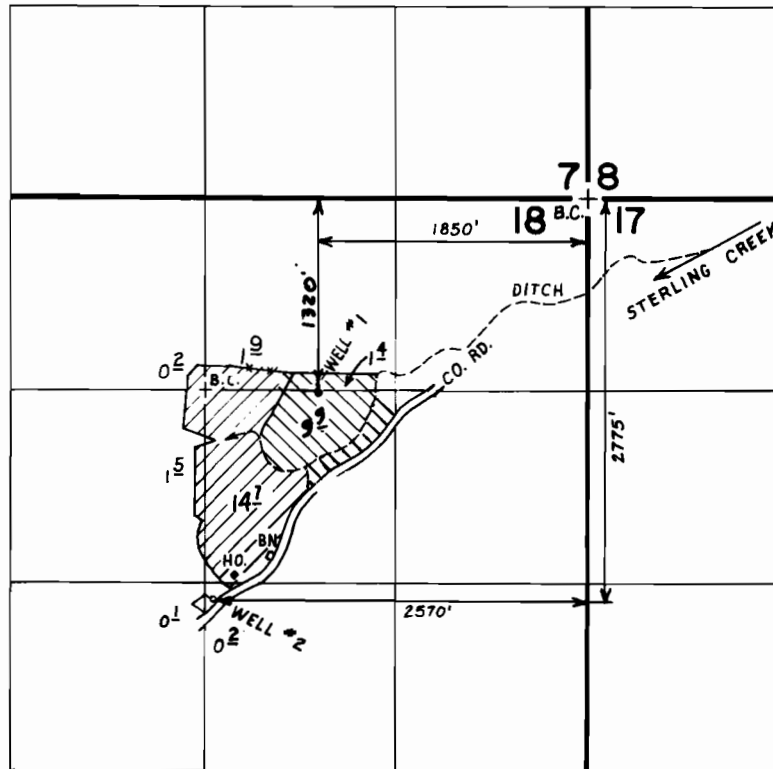

SCALE: 4" = 1 MILE

SUPPLEMENTAL IRRIGATION from WELL #1.

SUPPLEMENTAL IRRIGATION from WELL #2.

## FINAL PROOF SURVEY UNDER

Application No. G-9257 Permit No. G-8681.....  
IN NAME OF

EARL M. &/or KAREEN H. BROWN.....

Surveyed MAY 3..... 1982, by BRUCE R. SUND.....