


# T.39S., R.2W., W.M.

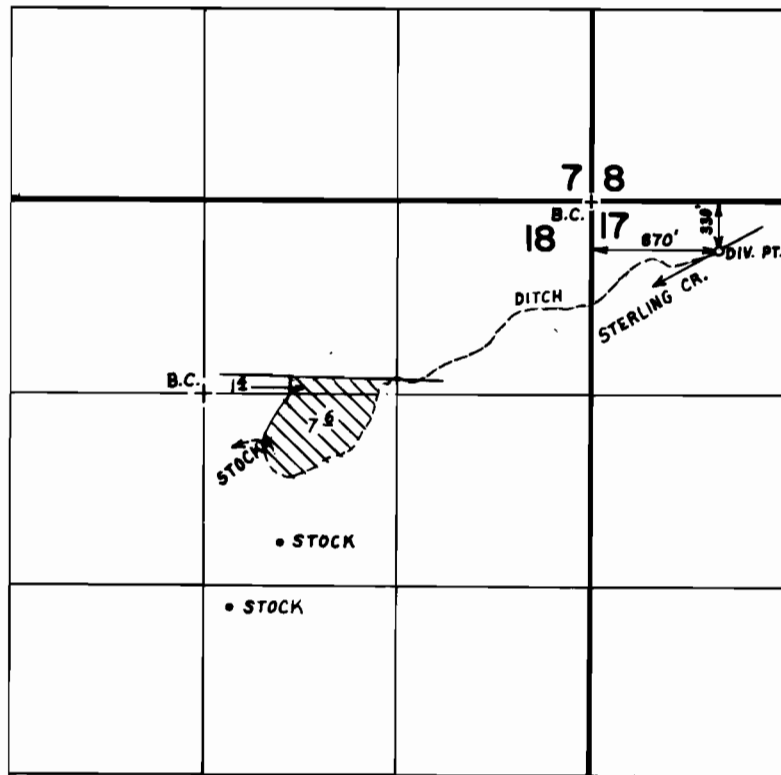

SCALE: 4" = 1 MILE

## FINAL PROOF SURVEY UNDER

Application No. 52025 Permit No. 39211  
IN NAME OF

EARL M. & KAREEN H. BROWN

Surveyed MAY 3 1982, by BRUCE R. SUND