


# T. 35 S., R. 7 W., W. M.

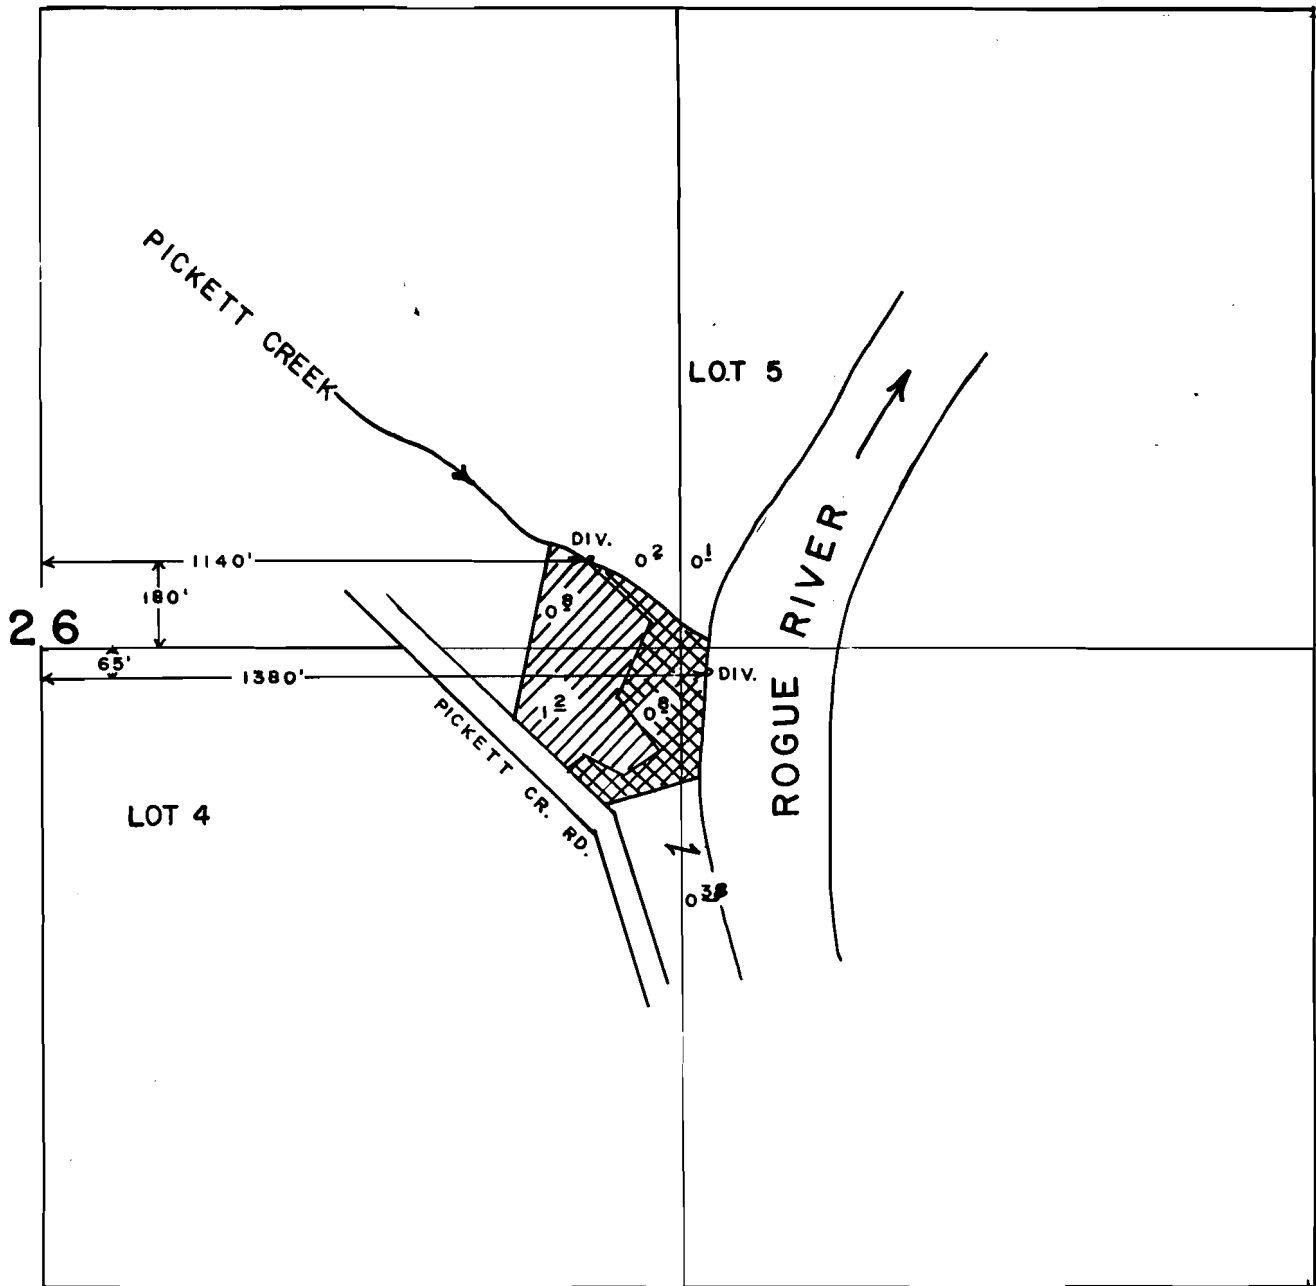

-  PRIMARY
-  SUPPLEMENTAL

## FINAL PROOF SURVEY UNDER

Scale:  
1" = 400'

Application No. 56.7.25 Permit No. 42.8.0.6.  
IN NAME OF

...THEO. R. AND BENNY R. MCGILL.....

Surveyed OCT. 22, 1985, by B. S. JAMES..