


T.35S., R.6 & 7W., W.M.

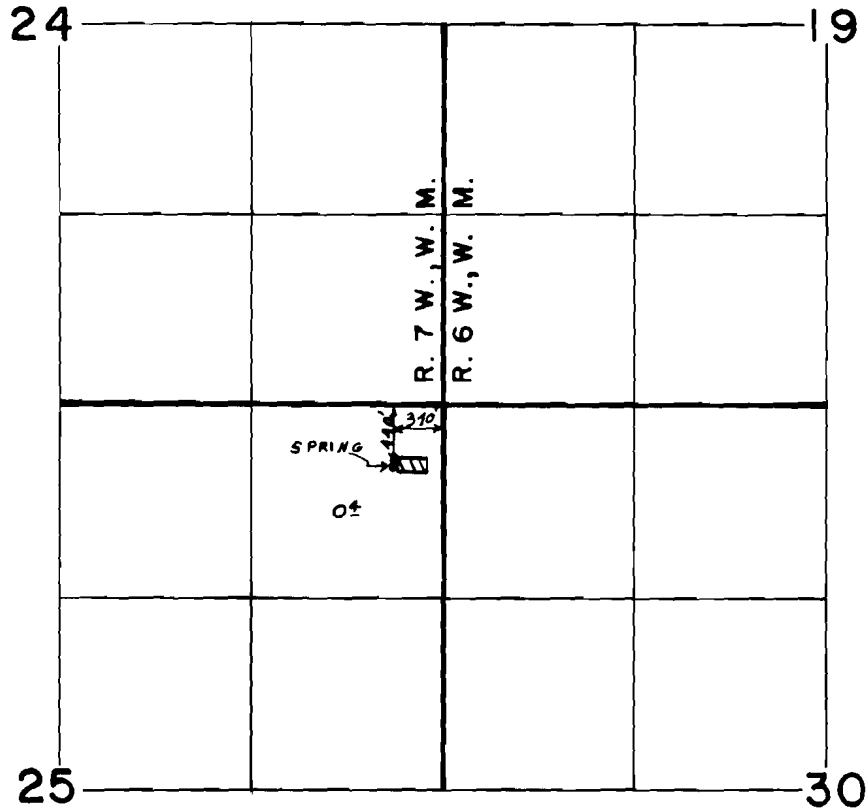

SCALE: 4" = 1 Mile

FINAL PROOF SURVEY UNDER

Application No. 56.7.7.0 Permit No. 4.2.591....
IN NAME OF

.....MARGARET ANN FUSILIER.....

Surveyed O.C.T. 24 19.8.5, by B.S. JAMES...