


T. 36 S., R. 5 W., W.M.

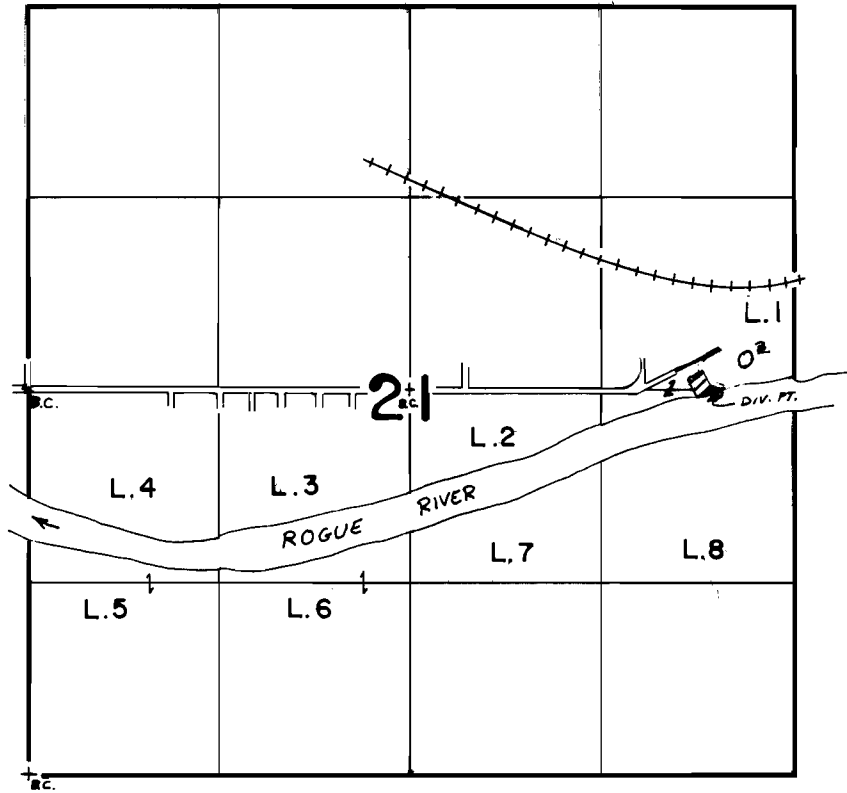

DIV. PT. : 20'S & 2130'E FROM CENTER 1/4 COR. SECTION 21

Scale 4" = 1 mile

**FINAL PROOF SURVEY**  
UNDER

Application No. 61.358. Permit No. 456.79...  
IN NAME OF

MYRON A. & JANE H. JOHNSON AND CHRISTIAN E. & HELEN M. JOHNSON

Surveyed Oct. 21, 1981, by Bruce R. Sund.